PREPARED FOR: PAUL LEWIS 275 CHRUCH DR. FONTANA, WI 53125


PLAT OF SURVEY

-OF-

KROTT SURVEYING INC.
N3705 WILLOW BEND LANE

N3705 WILLOW BEND LAN LAKE GENEVA WI. 53147 PHONE # (262)248-3697 FAX # (262)249-0639

LOTS 97, IN LAKE GENEVA HIGHLANDS SUBDIVISION, LOCATED IN TOWN 1 NORTH, RANGE 17 EAST, WALWORTH COUNTY, WISCONSIN.

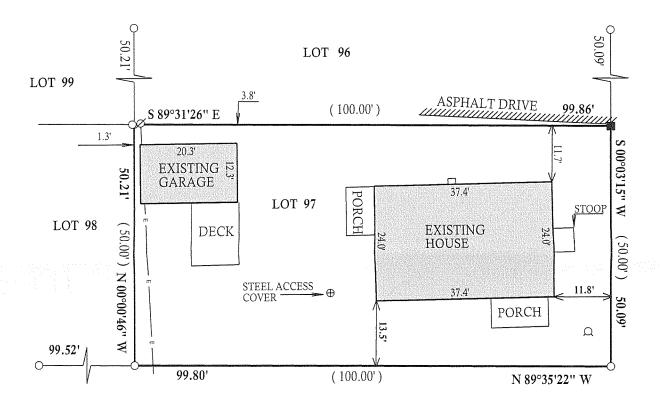

C.L. WOODLAND ROAD
(50' WIDE)

## C.L. SOUTHLAND ROAD

(50' WIDE)

## LEGEND

— E— OVERHEAD UTILITY WIRES

set Iron bar

○ FOUND IRON PIPE

FOUND IRON PIP

POWER POLE


⊕ STEEL LID

Q WELL

JOB # 08-201

(XX) RECORDED AS

TAX ID #ILGH00094

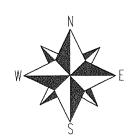

SCALE 1" = 20'

COMPARE LEGAL DESCRIPTION ABOVE AND DRAWING WITH DEED. FOR BUILDING RESTRICTIONS AND EASEMENTS NOT SHOWN, REFER TO DEED, ABSTRACT SOURCES AND LOCAL MUNICIPAL CODES. NOTIFY THE SURVEYOR IMMEDIATELY OF ANY DISCREPANCY.

"I hereby certify that I have surveyed the above described property and that the above map is a true representation thereof and shows the size and location of all visible structures, apparent easements and encroachments if any."

This survey is made for the present owners of the property, and those who purchase, mortgage, or guarentee the title thereto, within one year from the date hereof.



DATED THIS THE 11th DAY OF SEPTEMBER, 2008.

JOHN KROTT S - 2258 Wisconsin Registered Land Surveyor ( original if signed in red )