


# PLAT OF SURVEY



LOT 1 OF CERTIFIED SURVEY MAP NO. 4087

RECORDED IN VOLUME 25 ON PAGE 269 AS DOCUMENT NO. 720470  
 BEING LOCATED IN PART OF THE NORTHWEST 1/4 OF THE SOUTHEAST 1/4  
 OF SECTION 33, TOWN 1 NORTH, RANGE 17 EAST, WALWORTH COUNTY, WISCONSIN

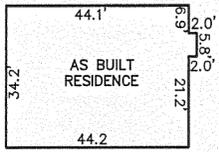

SCALE: 1"=30'



DETAIL

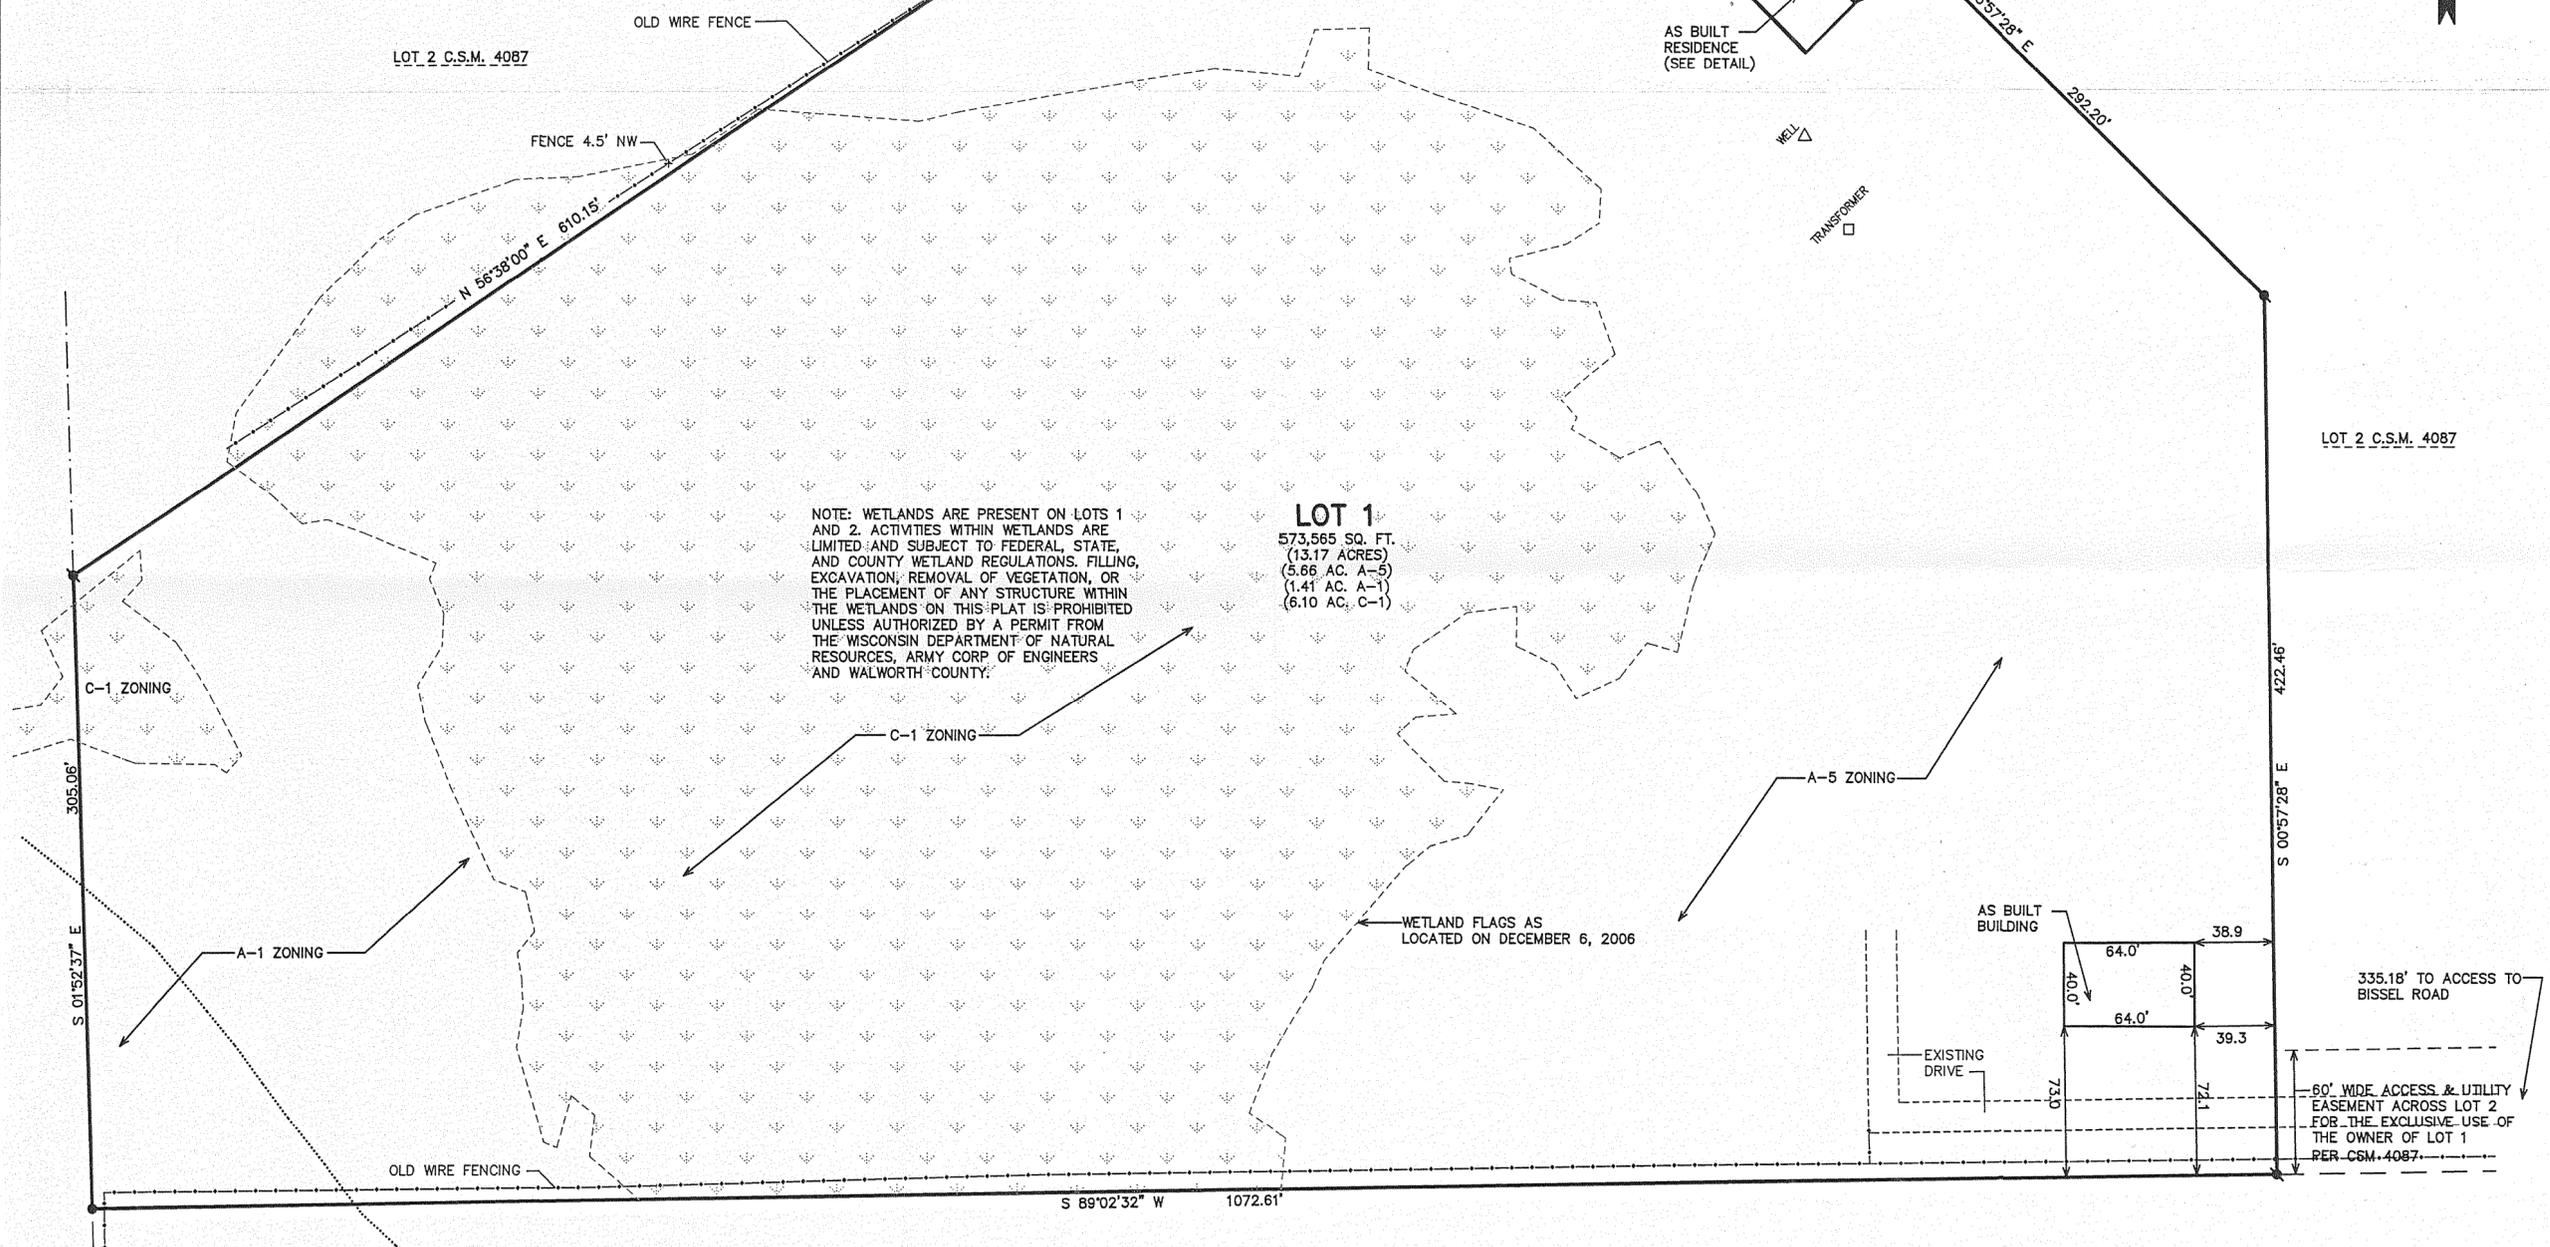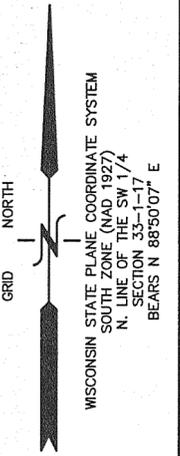

NOTE: WETLANDS ARE PRESENT ON LOTS 1 AND 2. ACTIVITIES WITHIN WETLANDS ARE LIMITED AND SUBJECT TO FEDERAL, STATE, AND COUNTY WETLAND REGULATIONS. FILLING, EXCAVATION, REMOVAL OF VEGETATION, OR THE PLACEMENT OF ANY STRUCTURE WITHIN THE WETLANDS ON THIS PLAT IS PROHIBITED UNLESS AUTHORIZED BY A PERMIT FROM THE WISCONSIN DEPARTMENT OF NATURAL RESOURCES, ARMY CORP OF ENGINEERS AND WALWORTH COUNTY.

**LOT 1**  
 573,565 SQ. FT.  
 (13.17 ACRES)  
 (5.66 AC. A-5)  
 (1.41 AC. A-1)  
 (6.10 AC. C-1)

- LEGEND
- = FOUND IRON REBAR STAKE, 3/4" DIA.
  - ⊙ = SET IRON REBAR STAKE, 3/4" DIA. x 24" x 1.50 lbs./ft.
  - {XXX} = RECORDED AS

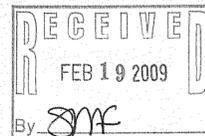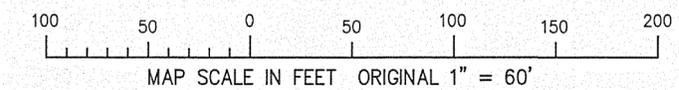

NOTE: COPIES OF THIS MAP TO WHICH THE FOLLOWING CERTIFICATE WILL APPLY SHOW SURVEYOR'S ORIGINAL SEAL AND SIGNATURE IN RED INK. COPIES BY ANY OTHER MEANS MAY HAVE ALTERATIONS WHICH DO NOT REPRESENT THE SURVEYOR'S WORK PRODUCT.


I HEREBY CERTIFY THAT THE ABOVE DESCRIBED PROPERTY HAS BEEN SURVEYED UNDER MY DIRECTION AND THAT THE ABOVE MAP IS A TRUE REPRESENTATION THEREOF AND SHOWS THE SIZE AND LOCATION OF THE PROPERTY, ITS EXTERIOR BOUNDARIES, THE LOCATION OF ALL VISIBLE STRUCTURES, AND DIMENSIONS OF ALL PRINCIPLE BUILDINGS THEREON, BOUNDARY FENCES, APPARENT EASEMENTS, ROADWAYS, AND VISIBLE ENCROACHMENTS, IF ANY. THIS SURVEY IS MADE FOR THE USE OF THE PRESENT OWNERS OF THE PROPERTY, AND ALSO THOSE WHO PURCHASE, MORTGAGE, OR GUARANTEE THE TITLE THERETO WITHIN ONE YEAR FROM THE DATE HEREOF.

DATED: JANUARY 30, 2008

*Peter S. Gordon*  
 PETER S. GORDON R.L.S. 2101

REVISED 08-06-2008 TO SHOW SIZE & LOCATION OF AS BUILT RESIDENCE & OUTBUILDING

REVISED 01-22-2009 TO UPDATE INFORMATION TO TITLE CERTIFICATION SPECIFICATIONS

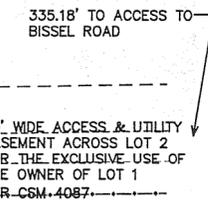

WORK ORDERED BY -  
 RYAN SOUTHWICK  
 910 WELLS STREET  
 LAKE GENEVA, WI 53147

FARRIS, HANSEN & ASSOCIATES, INC.  
 ENGINEERING - ARCHITECTURE - SURVEYING  
 7 RIDGWAY COURT P.O. BOX 437  
 ELKHORN, WISCONSIN 53121  
 OFFICE: (262) 723-2098 FAX: (262) 723-5886

REVISIONS	
PROJECT NO.	6948.08
DATE:	1/30/2008
SHEET NO.	1 OF 1

IA4087-1

117-3020