
ABELL SURVEYING & MAPPING

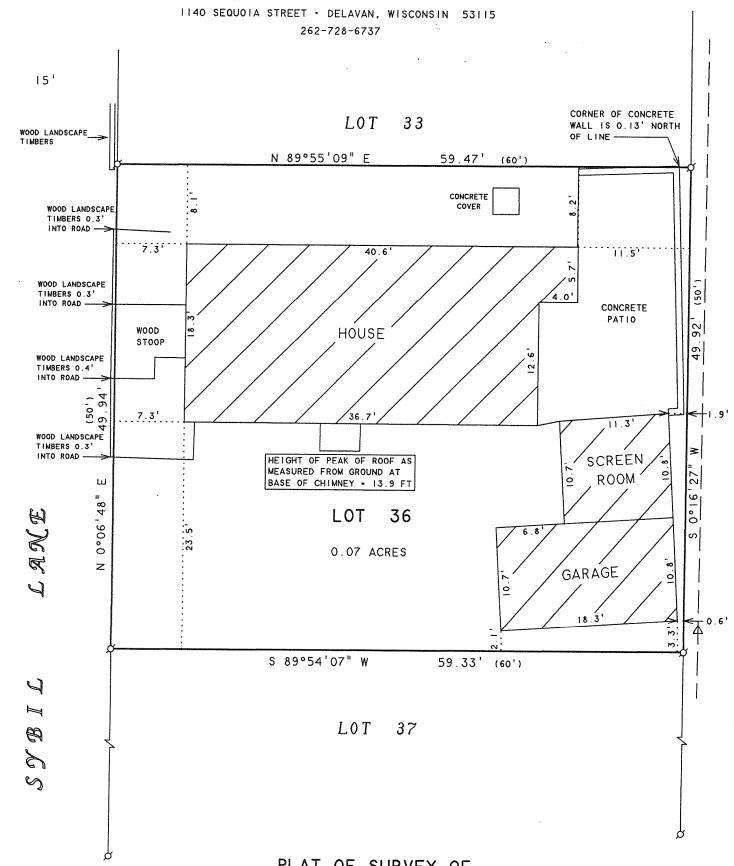

PLAT OF SURVEY OF

LOT 36 IN CAMP SYBIL, A SUBDIVISION LOCATED IN TIN.RITE. TOWN OF LINN. WALWORTH COUNTY. WISCONSIN.

NOTE: BEARINGS ARE REFERENCED TO EXISTING SURVEY RECORDS.





SCALE | "=10'

LEGEND

Ø - IRON PIPE FOUND △ - UTILITY POLE


- OVERHEAD UTILITY LINES ()- RECORDED AS

ORDERED BY: BILL KLEWIN

BK DESIGN 621 BOWERS BLVD. DELAVAN, WI 53115

OWNERS: DEAN AND MARY SCHRAUFNAGEL

REVISED DATE: FEBRUARY 2, 2009 REVISED TO SHOW HEIGHT OF PEAK OF ROOF.

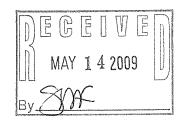

I HEREBY CERTIFY THAT I HAVE SURVEYED THE ABOVE DESCRIBED PROPERTY AND THAT THE ABOVE MAP IS A TRUE REPRESENTATION THEREOF AND SHOWS THE SIZE AND LOCATION OF THE PROPERTY. ITS EXTERIOR BOUNDARIES, THE LOCATION OF ALL VISIBLE STRUCTURES AND DIMENSIONS OF ALL PRINCIPAL BUILDINGS THEREON, BOUNDARY FENCES, APPARENT EASEMENTS, ROADWAYS AND VISIBLE ENCROACHMENTS, IF ANY, TO THE BEST OF MY KNOWLEDGE AND RELIFF KNOWLEDGE AND BELIEF.

THIS SURVEY IS MADE FOR THE USE OF THE PRESENT OWNERS OF THE PROPERTY, AND ALSO THOSE WHO PURCHASE, MORTGAGE, OR GUARANTEE THE TITLE THERETO WITHIN ONE (I) YEAR FROM DATE HEREON.

DAVID F. ABELL WISCONSIN REGISTERED LAND SURVEYOR, S-1596

JOB NUMBER - 07053A NOTE: THIS IS NOT A CERTIFIED COPY UNLESS SEALED.