


PLAT OF SURVEY
LOT 1 OF CERTIFIED SURVEY MAP NO. 4180
(FORMERLY LOTS 7-9 OF BLOCK D, CISCO BEACH SUBDIVISION)
LOCATED IN SECTION 5, TOWN 1 NORTH, RANGE 17 EAST
WALWORTH COUNTY, WISCONSIN



SHORE VIEW DRIVE
135' WIDE R.O.W.

GREENVIEW DRIVE
150' WIDE R.O.W.

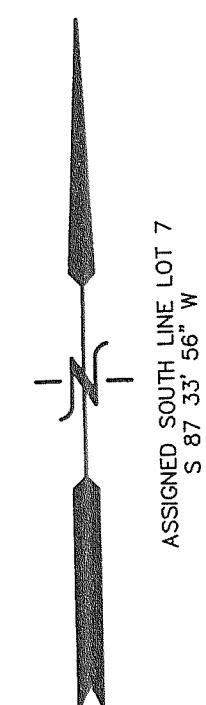

AREA SUMMARY:

TAX PARCEL ICI-81 (LOTS 7 & 8)	- 7,997 S.F. (0.18 ACRES)
TAX PARCEL ICI-83 & 86 (LOTS 9 & 12)	- 6,692 S.F. (0.15 ACRES)
TAX PARCEL ICI-88 (LOTS 13-15)	- 10,838 S.F. (0.25 ACRES)
TOTAL AREA	- 25,527 S.F. (0.59 ACRES)

BENCH MARK
NAIL IN SIDE
POWER POLE
ELEV.=101.24'

BENCH MARK
NAIL IN SIDE
POWER POLE
ELEV.=91.30'



NOTE: COPIES OF THIS MAP TO WHICH THE FOLLOWING CERTIFICATE WILL APPLY SHOW THE SURVEYOR'S ORIGINAL SEAL AND SIGNATURE IN RED INK. COPIES BY ANY OTHER MEANS MAY HAVE ALTERATIONS WHICH DO NOT REPRESENT THE SURVEYOR'S WORK PRODUCT.


I HEREBY CERTIFY THAT THE ABOVE DESCRIBED PROPERTY HAS BEEN SURVEYED UNDER MY DIRECTION AND THAT THE ABOVE MAP IS A TRUE REPRESENTATION THEREOF AND SHOWS THE SIZE AND LOCATION OF THE PROPERTY, ITS EXTERIOR BOUNDARIES, THE LOCATION OF ALL VISIBLE STRUCTURES, AND DIMENSIONS OF ALL PRINCIPLE BUILDINGS THEREON, BOUNDARY FENCES, APPARENT EASEMENTS, ROADWAYS, AND VISIBLE ENCROACHMENTS, IF ANY. THIS SURVEY IS MADE FOR THE USE OF THE PRESENT OWNERS OF THE PROPERTY, AND ALSO THOSE WHO PURCHASE, MORTGAGE, OR GUARANTEE THE TITLE THERETO WITHIN ONE YEAR FROM THE DATE HEREOF.

DATED: DECEMBER 5, 2007

REVISOR 10-31-2008
TO SHOW SIZE & LOCATION OF
AS-BUILT FOUNDATION

REVISOR 7/20/2009
TO UPDATE MAP TO TITLE
SURVEY SPECIFICATIONS

- LEGEND
- ✕ = SET "PK" NAIL IN PAVEMENT
 - = SET IRON REBAR STAKE
 - = FOUND IRON PIPE STAKE
 - ⊙ = FOUND IRON REBAR STAKE
 - [xxx] = RECORDED AS

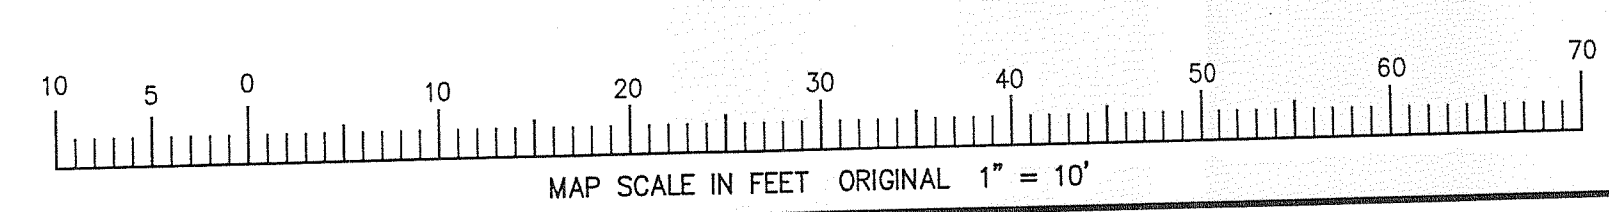

WORK ORDERED BY:
LOWELL MANAGEMENT
PO BOX 926
LAKE GENEVA, WI. 53147

FARRIS, HANSEN & ASSOCIATES, INC.
ENGINEERING - ARCHITECTURE - SURVEYING
7 RIDGWAY COURT P.O. BOX 437
ELKHORN, WISCONSIN 53121
OFFICE: (262) 723-2098 FAX: (262) 723-5886

REVISIONS	
PROJECT NO.	7504
DATE	12-05-2007
SHEET NO.	1 OF 1

117-3066

IA 4180-1