

MARY MCARTHUR  
1006 19th st  
PALM HARBOR FL. 34683



PLAT OF SURVEY

KROTT SURVEYING INC.

N3705 WILLOW BEND LANE  
LAKE GENEVA WI. 53147  
PHONE # (262)248-3697  
FAX # (262)249-0639

-OF-

LOTS 42, 43 AND 44 IN ROBINSON'S SECOND SUBDIVISION OF PART  
OF SECTIONS 11 AND 14 IN , T.1.N. , R.17.E. , TOWN OF LINN ,  
WALWORTH COUNTY, WISCONSIN.

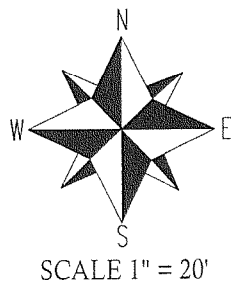
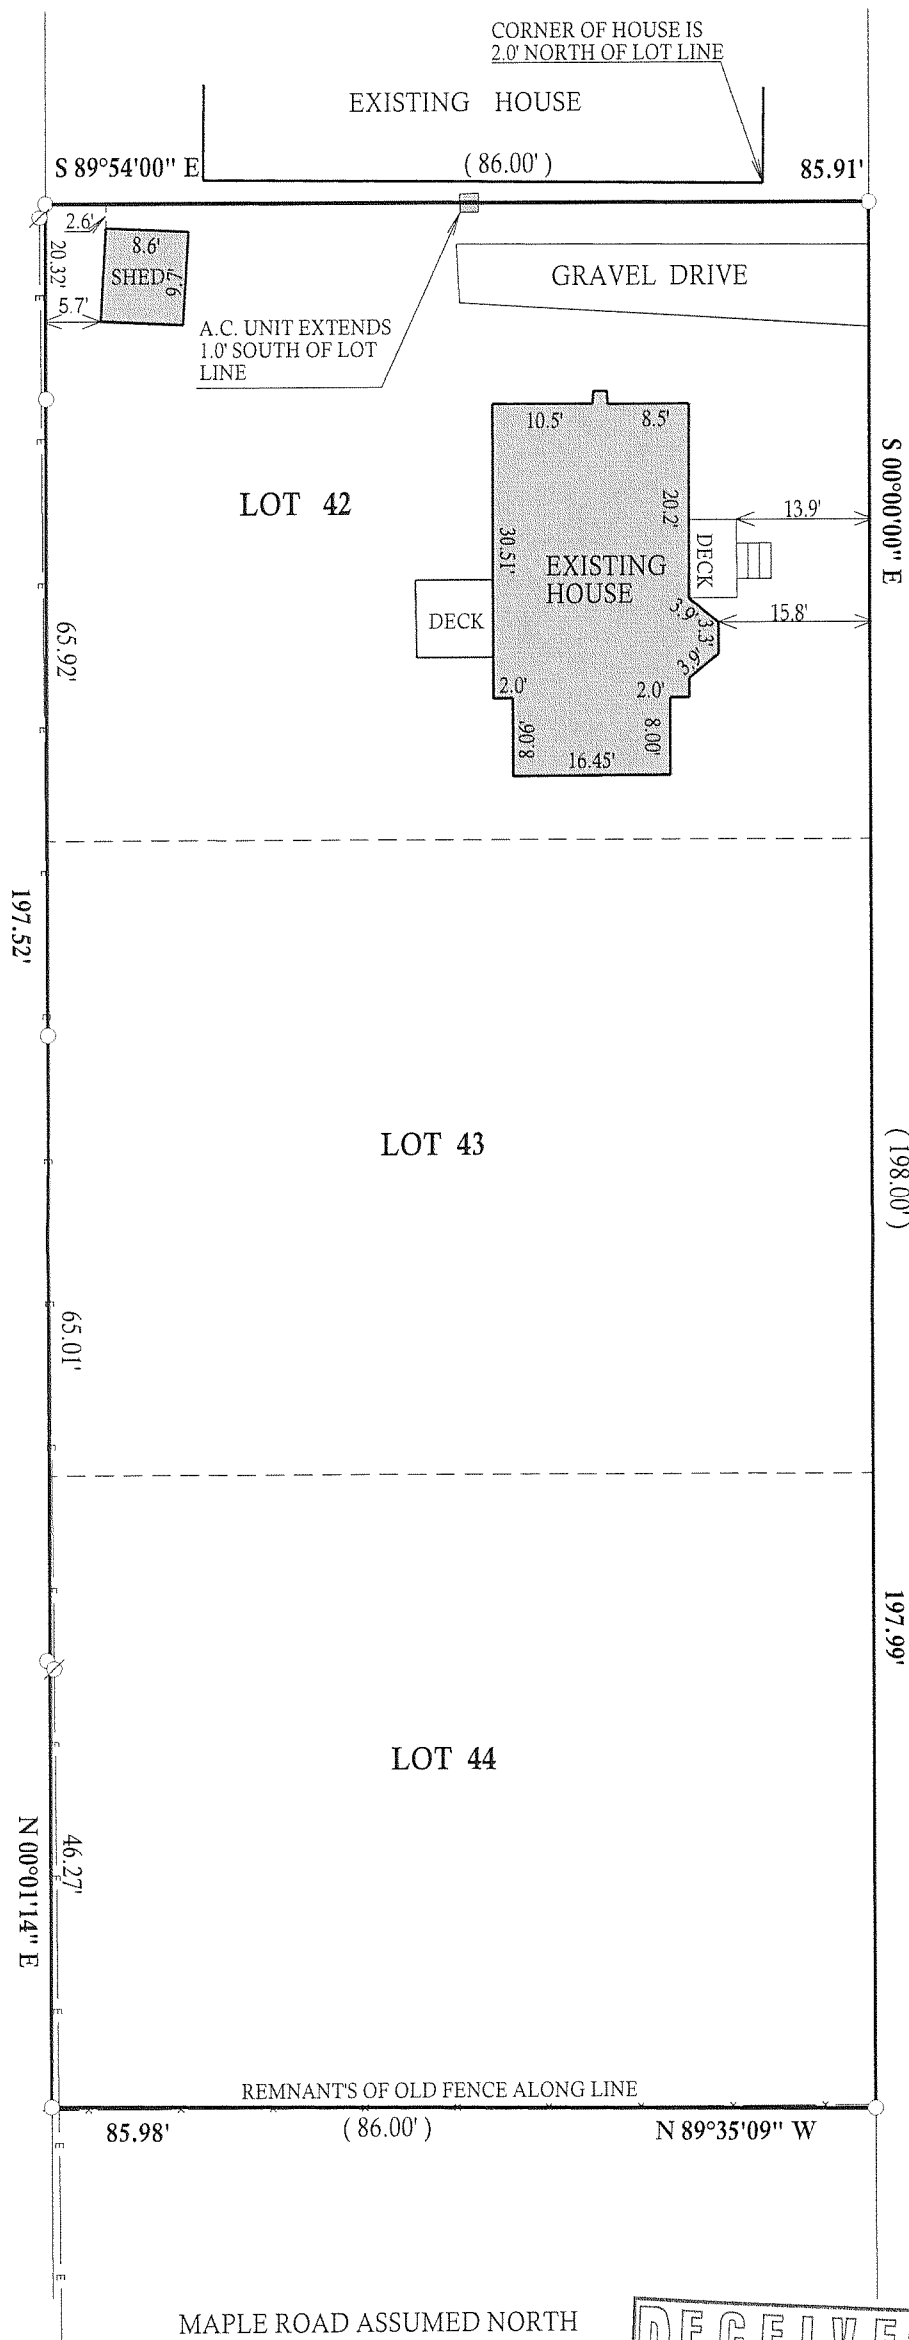


LEGEND

- E — OVERHEAD UTILITIES
- FOUND IRON PIPE
- FOUND IRON BAR
- SET IRON BAR
- (XX) RECORDED AS

JOB # 09-085 TAX ID # IRB00033

"I hereby certify that I have surveyed the above described property and that the above map is a true representation thereof and shows the size and location of all visible structures, apparent easements and encroachments if any."  
This survey is made for the present owners of the property, and those who purchase, mortgage, or guarantee the title thereto, within one year from the date hereof.

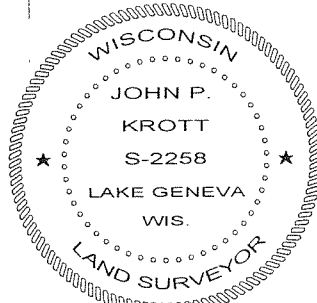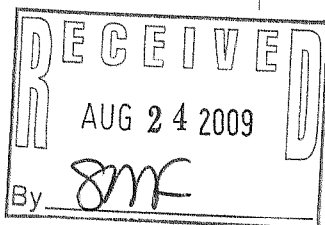

DATED THIS 9th, DAY OF JULY, 2009

*John P. Krott*  
JOHN KROTT S - 2258  
Wisconsin Registered Land Surveyor  
( original if signed in red )

IRB2 - 33

117-3072