

PREPARED FOR
JOAN FREYTAG
KEEFE REAL ESTATE
751 GENEVA PARKWAY
LAKE GENEVA WI. 53147

PLAT OF SURVEY

-OF-

LOTS 3 AND 4 BLOCK 3 OF WOODDALE ADDITION
A SUBDIVISION LOCATED IN THE TOWN OF LINN,
WALWORTH COUNTY, WISCONSIN.

KROTT SURVEYING INC.



N3705 WILLOW BEND LANE

LAKE GENEVA WI. 53147


PHONE # (262)248-3697

FAX # (262)249-0639

C.L. FAIR OAKS ROAD
(40' WIDE)

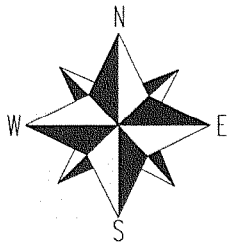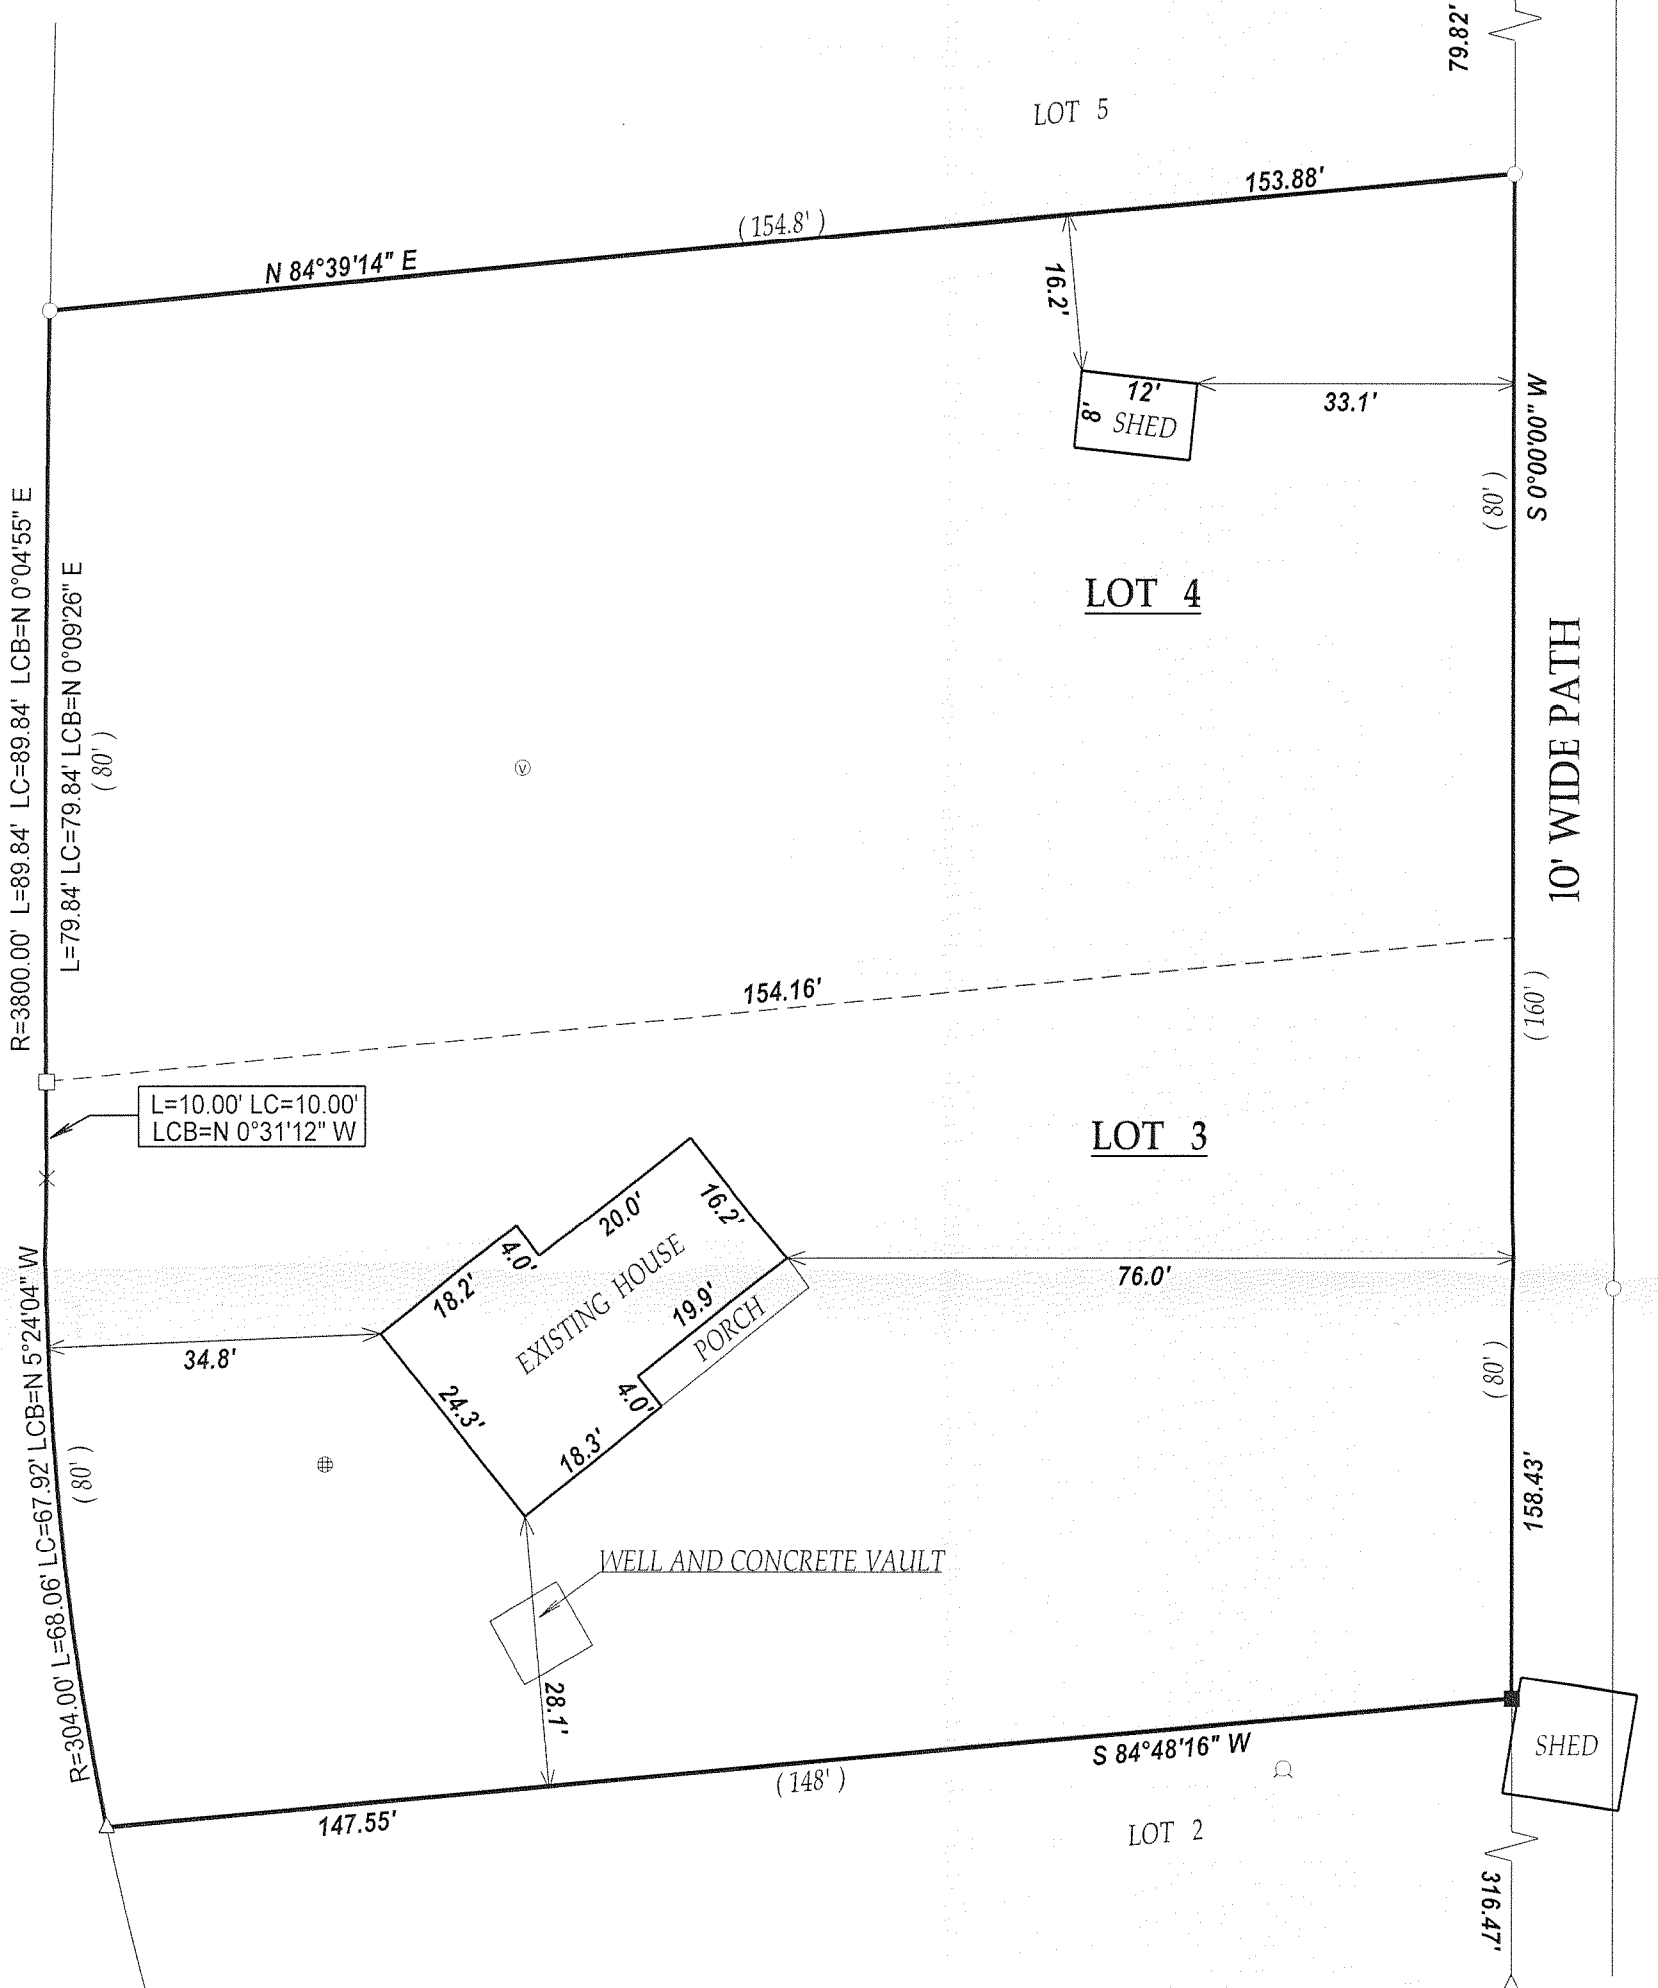



SCALE 1" = 20'

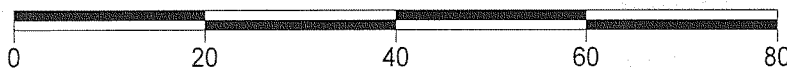

I have surveyed the above-described property and the above map is a true representation thereof and shows the size and location of the property, its exterior boundaries, the location and dimensions of all structures thereon, fences apparent easements and roadways and visible encroachments, if any.

This survey is made for the exclusive use of the present owners of the property, and also those who purchase, mortgage, or insure the title thereto within one (1) year from date hereof; and as to them I warrant the accuracy of said survey map.

NOTE : BASIS OF BEARING IS PREVIOUS SURVEY RECORDS

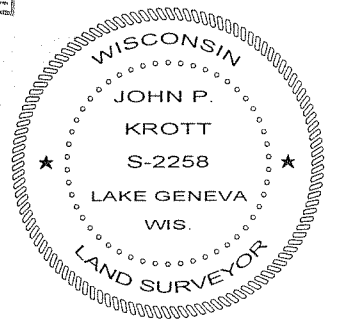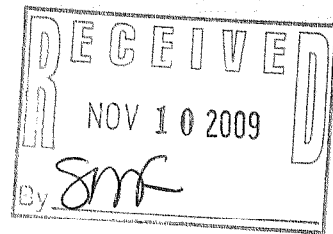

DATED THIS 21st DAY OF SEPTEMBER 2009.

John P. Krott
JOHN KROTT S - 2258
Wisconsin Registered Land Surveyor
(original if signed in red)

117 - 3098