


PREPARED FOR
LAURA RODRIGUEZ
KEEFE REAL ESTATE
751 GENEVA PARKWAY
LAKE GENEVA WI. 53147

PLAT OF SURVEY


OF

KROTT SURVEYING INC.
N3705 WILLOW BEND LANE
LAKE GENEVA WI. 53147
PHONE # (262)248-3697
FAX # (262)249-0639

LOT 7 IN BLOCK 1 (EXCEPT THAT PORTION DESCRIBED AS FOLLOWS, TO-WIT: BEGINNING AT THE SOUTHWEST CORNER OF LOT 7 BLOCK 1, OF WOODDALE ADDITION, THENCE IN A NORTHWESTERLY DIRECTION ALONG THE BOUNDRY LINE BETWEEN LOTS 6 AND 7 BLOCK 1, TO THE SHORE OF GENEVA LAKE AT LOW WATER MARK; THENCE IN AN EASTERLY DIRECTION, ALONG THE SHORE OF GENEVA LAKE AT LOW WATER MARK 35 FEET TO A POINT; THENCE STRAIGHT IN A SOUTHEASTERLY DIRECTION TO A POINT IN THE SOUTH LINE OF LOT 7 WHICH IS 28 FEET IN A NORTHEASTERLY DIRECTION FROM THE SOUTHWEST CORNER OF SAID LOT; THENCE IN A SOUTHWESTERLY DIRECTION ALONG THE SOUTHERLY BOUNDRY LINE OF SAID LOT, 28 FEET TO THE SOUTHWEST CORNER OF LOT 7, BLOCK 1 AND THE PLACE OF BEGINNING.) ALL IN SUBDIVISION KNOWN AND DESCRIBED AS WOODDALE ADDITION LOCATED IN SECTION 9, TOWN 1 NORTH, RANGE 17 EAST, WALWORTH COUNTY, WISCONSIN.

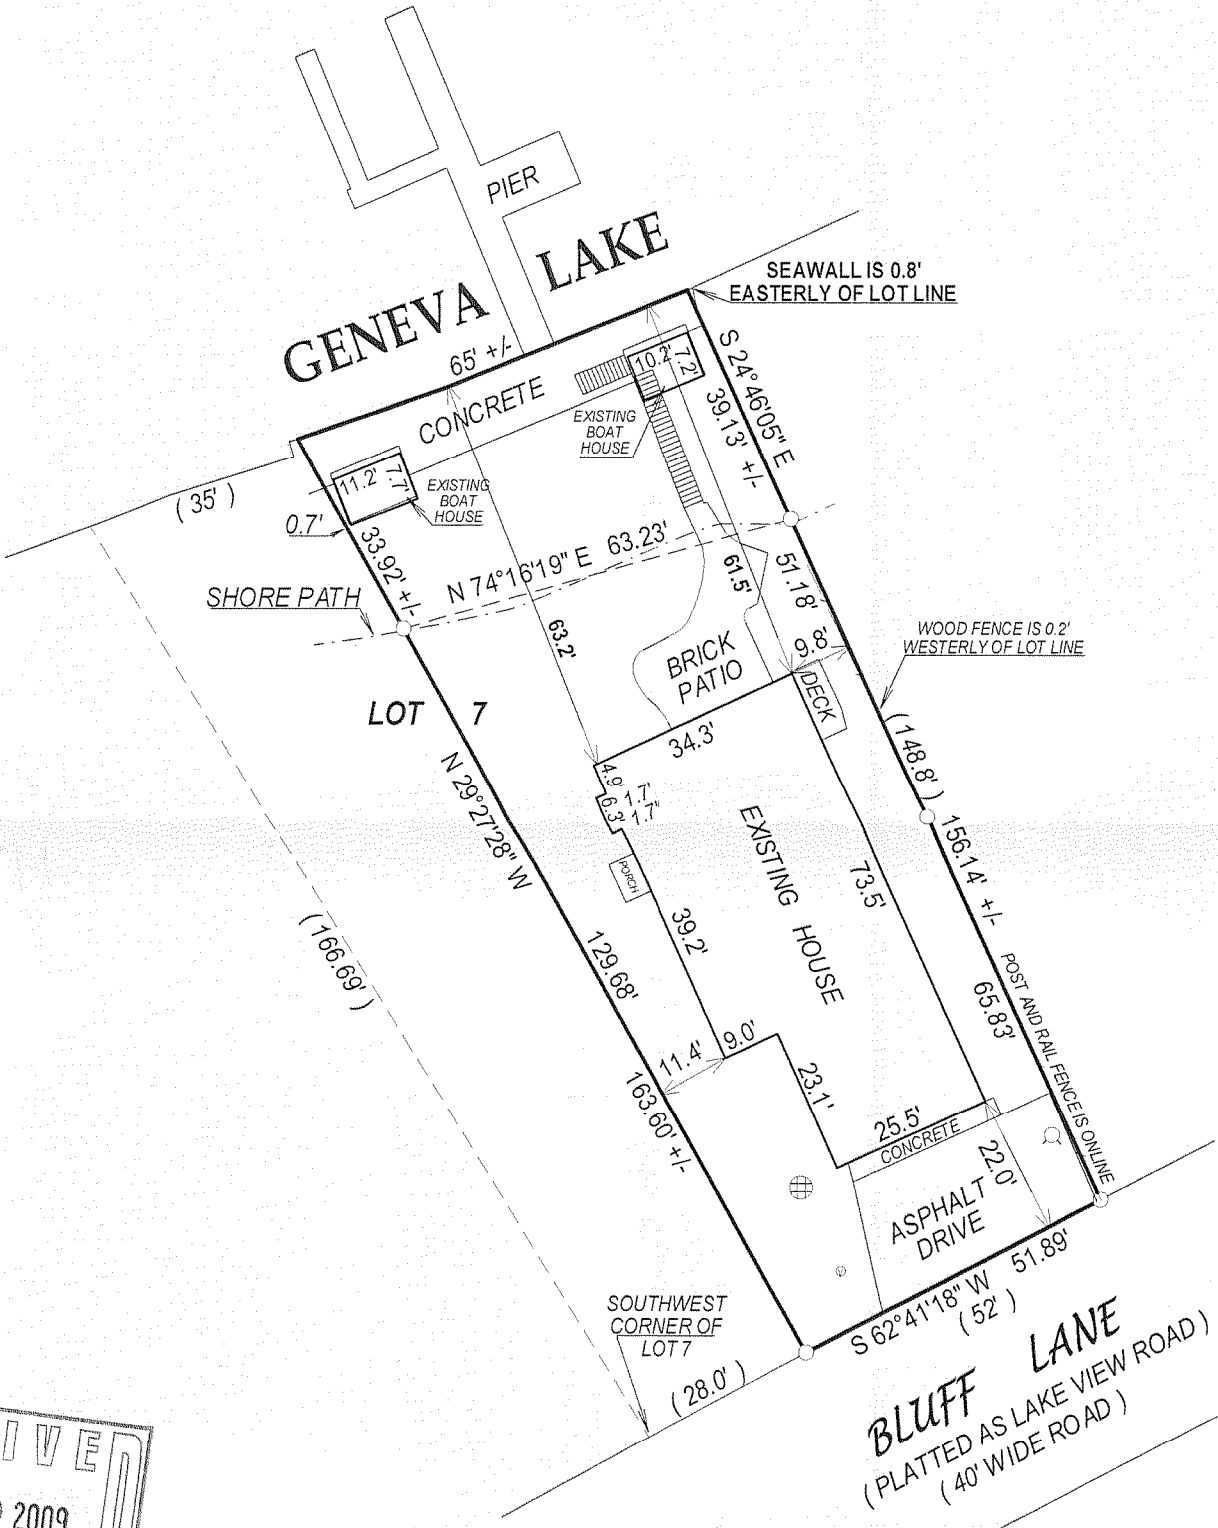

RECEIVED
NOV 10 2009
By *SMF*

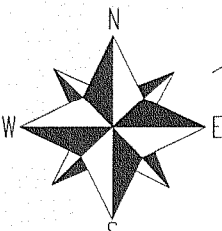


- LEGEND
- FOUND IRON PIPE
 - WELL
 - ⊗ CONCRETE LID
 - VENT

(XX) RECORDED AS
TAX ID # IW00008 & 8B
JOB # 09-154

I have surveyed the above-described property and the above map is a true representation thereof and shows the size and location of the property, its exterior boundaries, the location and dimensions of all structures thereon, fences apparent easements and roadways and visible encroachments, if any.

This survey is made for the exclusive use of the present owners of the property, and also those who purchase, mortgage, or insure the title thereto within one (1) year from date hereof; and as to them I warrant the accuracy of said survey map.

NOTE : BEARINGS ARE REFRENCED TO PREVIOUS SURVEY RECORDS.

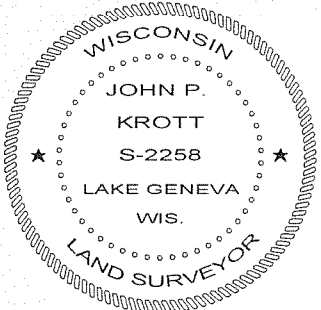

DATED THIS 26th DAY OF OCTOBER 2009.

John P. Krott

JOHN KROTT S - 2258
Wisconsin Registered Land Surveyor
(original if signed in red)

117-3101