



**REGISTERED PROFESSIONAL LAND SURVEYOR  
LAKE GENEVA, WISCONSIN**



**WILLIAM H. WILSON**

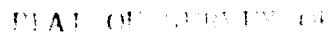

- Φ - IRON PIPE FOUND
- - IRON PIPE PLACED
- - CONCRETE MONUMENT
- X - SPIKE
- ( ) - AS PLATTED...

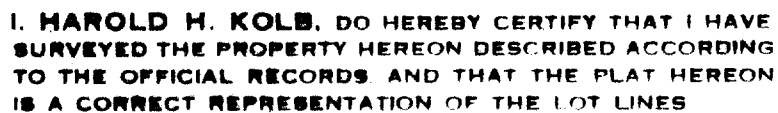

**HAROLD H. KOLB**  
**WISCONSIN REGISTERED LAND SURVEYOR. S-187**

DATE August 14, 1972

7 RH-134  
" 13B

117-312