

AARON & CHRISSY TAYLOR  
1540 GRACE STREET  
CHICAGO, IL 60613  
C/O MYEFSKI COOK ARCHITECTS, INC.


ENGINEERING - ARCHITECTURE - SURVEYING  
7 RIDGWAY COURT P.O. BOX 437  
EVLUEN, WISCONSIN 57404

9-18-2009  
ROAD EROSION CONTROL  
FO.  
/25/2009-KB  
SHOW SIZE &  
LOCATION OF AS-BUILT  
BUILDINGS

TE  
9/17/2009

SHEET NO.  
1 OF 1

LEGAL DESCRIPTION OF RECORD FROM TITLE COMMITMENT PROVIDED BY CLIENT

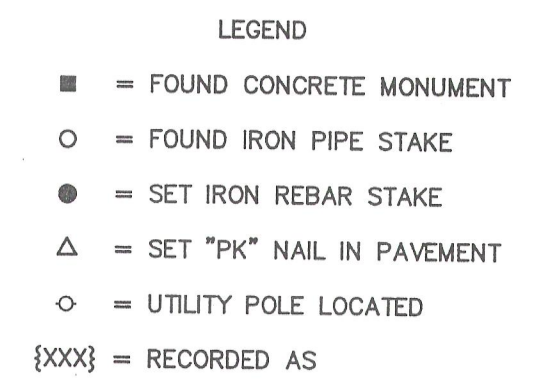


I HEREBY CERTIFY THAT THE ABOVE DESCRIBED PROPERTY HAS BEEN SURVEYED UNDER MY DIRECTION AND THAT THE ABOVE MAP IS A TRUE REPRESENTATION THEREOF AND SHOWS THE SIZE AND LOCATION OF THE PROPERTY, ITS EXTERIOR BOUNDARIES, THE LOCATION OF ALL EXISTING AND PROPOSED STRUCTURES, EASEMENTS, ENCROACHMENTS, BUILDINGS THEREON, BOUNDARY FENCES, APPARENT EASEMENTS, ROADSWAYS, AND ADJACENT LANDS. IF ANY, THE NAME OF THE PERSONS WHOSE INTERESTS ARE CLAIMED BY THE PRESENT OWNERS OF THE PROPERTY, AND ALSO THOSE WHO HAVE CLAIMED, OR GUARANTEE THE TITLE THERETO WITHIN ONE YEAR FROM THE DATE HEREOF.

THE DATE OF THE SURVEY OF THE LANDS SURROUNDING THE ABOVE AREA "C" (AREAS OF MINIMAL FLOODING), AS SHOWN ON FLOOD INSURANCE RATE MAP (FIRM NO. 50064E) WAS THE DATE OF THE SURVEY OF THE LANDS SURROUNDING THE ABOVE AREA "B" (SOMEWHAT FLOOD MANAGEMENT AREA) ON AUGUST 15, 1983 AS PUBLISHED BY THE FEDERAL EMERGENCY

PETER S. GORDON

RECEIVED  
JAN 11 2010  
By *Em*

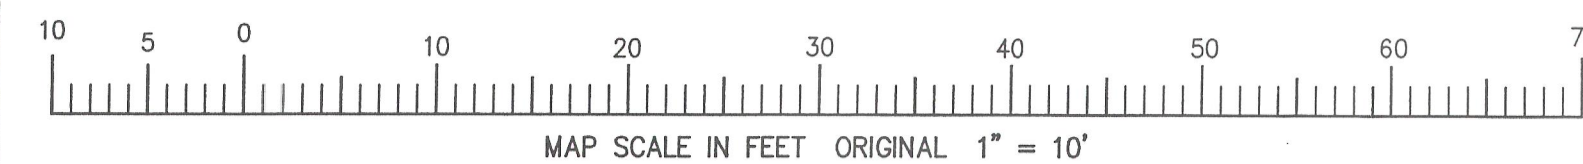

ICI-17

117-3127

11/25/2009 X:\Projects\7637\DCAD\ASBUILT\_2009\125

NOV 25 2009