


DESCRIPTION; Plat of survey showing the location of the house on the North 200 feet of Lot #7 South of roadway (as measured along the West line) and a portion of Lot #8 in S.B. Chapins Subdivision Sec. 4, T. 1 N., R. 17 E. Walworth County, Wisc.

CERTIFICATE: I, James F. Biagi, surveyor, do hereby certify that I have surveyed the property hereon described, and that the location of the improvements are as shown on the plat above.

James F. Biagi
 James F. Biagi
 WISCONSIN
 JAMES F. BIAGI
 MILWAUKEE,
 WIS.
 LAND SURVEYOR

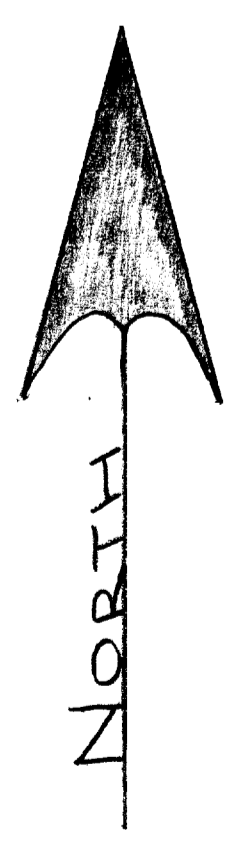

O-INDICATES IRON PIPE
 O-INDICATES CONC. MON.
 SCALE: 1" = 10'-0"

ICH-2A4, 2B