PLAT OF SURVEY

LOCATED IN THE SW 1/4 OF THE SW 1/4 OF SECTION 11 TOWN 1 NORTH, RANGE 17 EAST WALWORTH COUNTY, WISCONSIN

- WORK ORDERED BY -KEEFE REAL ESTATE 751 GENEVA PARKWAY LAKE GENEVA, WI. 53147




Lots 139 and 140 of Lake Geneva Beach, a subdivision located in the Township of Linn, Walworth County, Wisconsin.

Tax Key No. ILGB 00126

SOUTH LINE LOT 139

ASSIGNED

89 18'42"

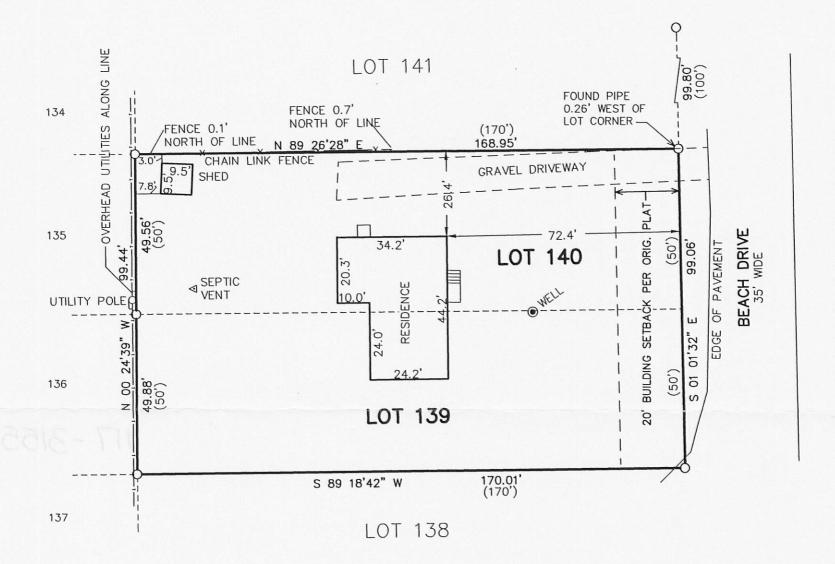

LEGEND O = FOUND IRON PIPE STAKE (XXX) = RECORDED ASAREA SURVEYED = 16,820 SQ. FT.




NOTE: COPIES OF THIS MAP TO WHICH THE FOLLOWING CERTIFICATE WILL APPLY SHOW SURVEYOR'S ORIGINAL SEAL AND SIGNATURE IN RED INK. COPIES BY ANY OTHER MEANS MAY HAVE ALTERATIONS WHICH DO NOT REPRESENT THE SURVEYOR'S WORK PRODUCT.

I HEREBY CERTIFY THAT THE ABOVE DESCRIBED PROPERTY HAS BEEN SURVEYED UNDER MY DIRECTION AND THAT THE ABOVE MAP IS A TRUE REPRESENTATION THEREOF AND SHOWS THE SIZE AND LOCATION OF THE PROPERTY, ITS EXTERIOR BOUNDARIES, THE LOCATION OF ALL VISIBLE STRUCTURES, AND DIMENSIONS OF ALL PRINCIPLE BUILDINGS THEREON, BOUNDARY FENCES, APPARENT EASEMENTS, ROADWAYS, AND VISIBLE ENCROACHMENTS, IF ANY. THIS SURVEY IS MADE FOR THE USE OF THE PRESENT OWNERS OF THE PROPERTY, AND ALSO THOSE WHO PURCHASE, MORTGAGE, OR GUARANTEE THE TITLE THERETO WITHIN ONE YEAR FROM THE DATE HEREOF.

DATED: FEBRUARY 10, 2010

PETER S. GORDON R.L.S. 2101

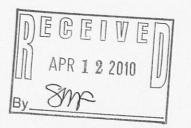



PROJECT: 8067 DATE: 02-10-2010 SHEET 1 OF 1

FEB 10 2011, ILGB-126

117-3155

2/10/2010