

# Plat of Survey

of

## Lots 6, 7, 8 and 9 of Lake Geneva Beach,

a subdivision located in Government Lot 4 in Section 11, Town 1 North, Range 17 East, Town of Linn, Walworth County, Wisconsin.

Surveyed for: **Z-Shape LLC**  
N687 Thunderbird Road  
Genoa City, Wisconsin. 53128

Survey Date: August 30, 2000.  
Revisions: No. 1 - Contours  
No. 2 - As-built additions  
& misc. locations  
in Nov. 2009.

Scale in Feet  
1" = 20'  
0 10 20 40'

**Jensen & Olson Land Surveying, LLC**  
45 South Wisconsin Street P.O. Box 322  
Elkhorn, Wisconsin 53121  
Telephone (262) 723-3434  
Facsimile (262) 723-8044


**Legend**  
Found Concrete Monument  
Found Iron Pipe  
Set Iron Rod 3/4" dia.  
Found Information  
Concrete Core  
Asphalt Surface  
Concrete Surface  
Concrete Pole

Sheet 1 of 1 Sheets  
Job Reference Number  
**2009.111**  
2009.111


Geneva  
Lake

Water elevation on 8-30-00 = 864.2.

865 is the 100 year floodplain elevation per  
Walworth County Flood Insurance Rate Map,  
Community Panel No. 550462 0130 B dated  
August 15, 1983.

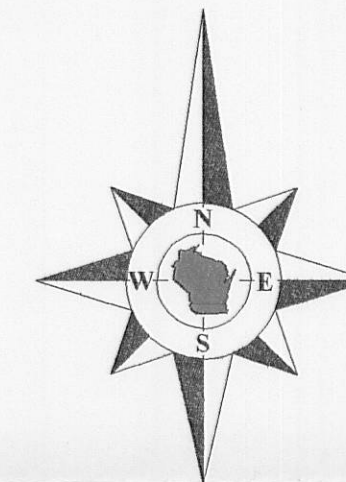

Bearings referenced to  
previous surveys.

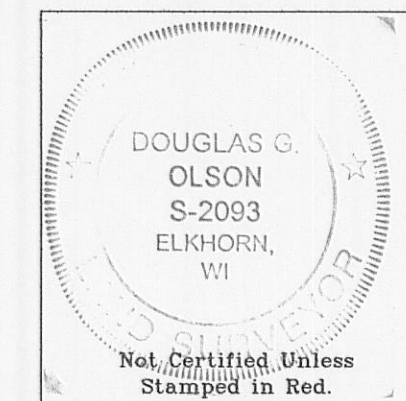


- Notes: 1) This survey plat is not certified unless signed and sealed in red ink.  
2) This survey is subject to Wisconsin lien laws. This Plat of Survey is the notice of intent to file lien. Lien waiver required.

Copyright 2000 by Jensen & Olson Land Surveying, LLC.

All rights reserved. No part of this survey plat may be reproduced or transmitted in any form by any means - graphic, electronic, or mechanical, including photocopying, tracing, or information storage and retrieval systems - without permission in writing from Douglas G. Olson, Jensen & Olson Land Surveying, LLC.

I, Douglas G. Olson, Wisconsin Registered Land Surveyor, do hereby certify that this survey was performed by me or under my direction in full compliance with the owner's/agent's instructions and Chapter A-E 7 of the Wisconsin Administrative Code "Minimum Standards for Property Surveys"; and that this map is an accurate representation thereof to the best of my knowledge and belief.

Douglas G. Olson  
Wisconsin Registered Land Surveyor - 2093

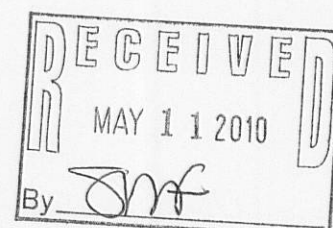

Note: Elevations referenced to a recorded elevation of 866.58 on the meander corner on the West line of the Southwest 1/4 of Section 11-1-17.  
Meander corner is approx. 220' west of this parcel.

Park Drive (30' Wide)

Spring Road

ILGB-3

117-3187