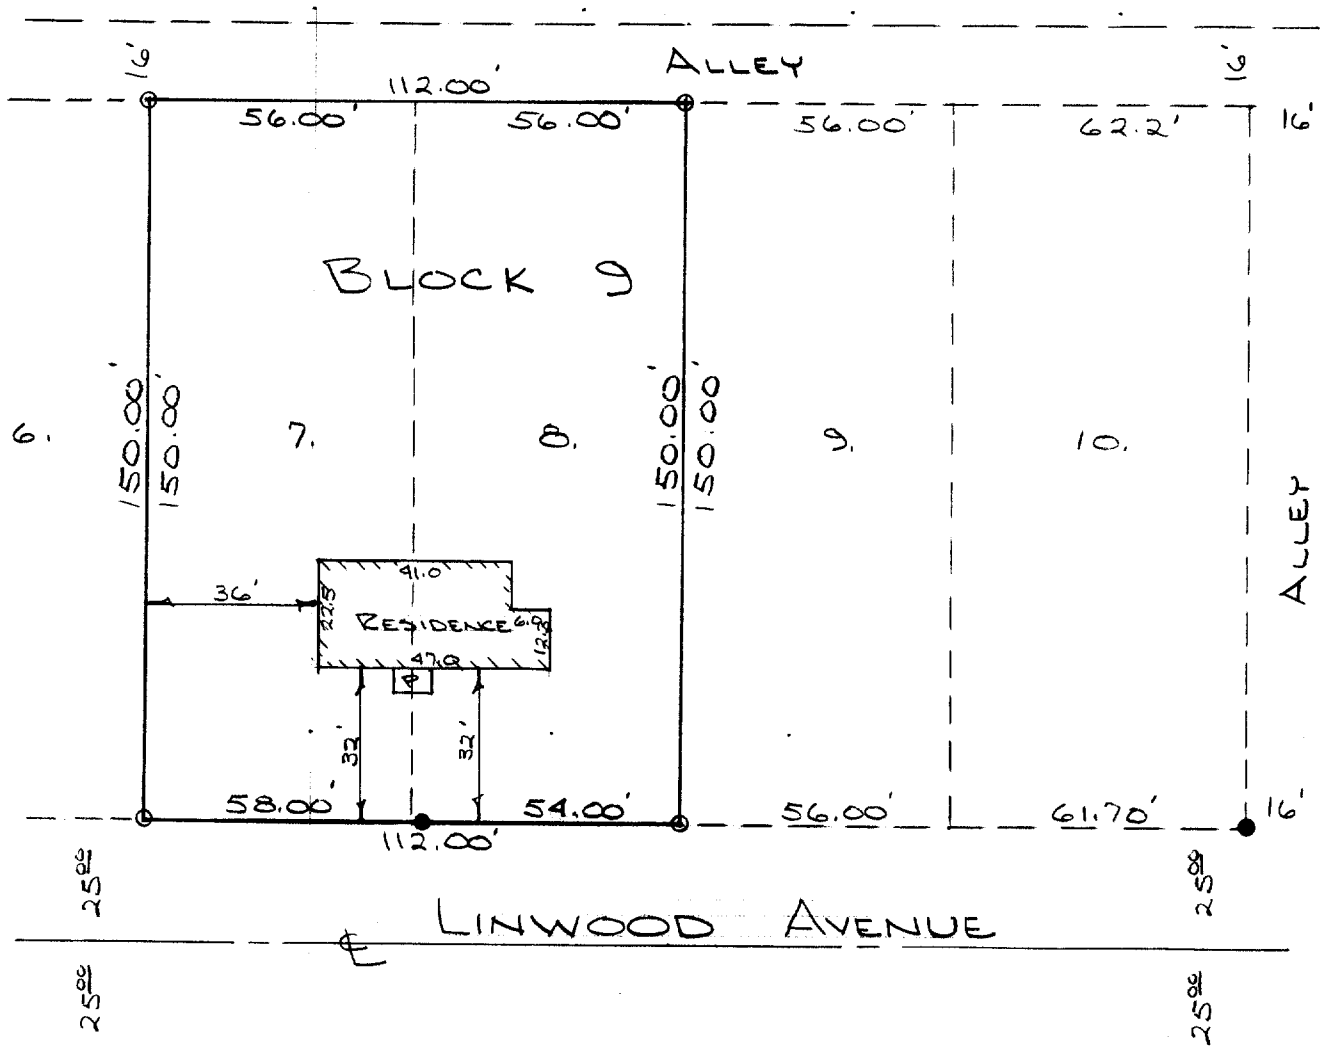


#81/72

113-384

● - INDICATES IRON PIPE FOUND
 ○ - INDICATES IRON PIPE SET

DESCRIPTION:

Lot number Seven (7) and Lot number Eight (8) in Block number Nine (9) of Genevista Subdivision located in the SW $\frac{1}{4}$ of the SW $\frac{1}{4}$ of Section 10, Town 1 North, Range 17 East, Walworth County, Wisconsin.


CERTIFICATE:

I, James F. Biagi, surveyor, do hereby certify that I have surveyed the lands hereon described.

July 6, 1972

James F. Biagi
 James F. Biagi

RLS #272

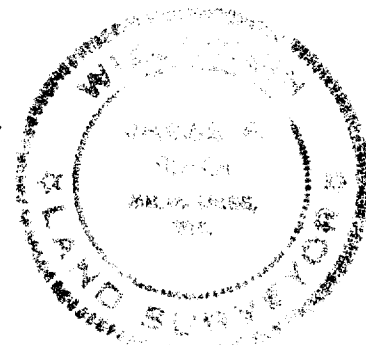

I G V - 54B

117-324