## FARRIS, HANSEN & ASSOCIATES, INC.

ENGINEERING - ARCHITECTURE - SURVEYING 7 RIDGWAY COURT - P.O. BOX 437 - ELKHORN, WISCONSIN 53121 PHONE: (262) 723-2098 FAX: (262) 723-5886


## PLAT OF SURVEY

LOT 8, BLOCK 6 OF LAKEVIEW PARK SUBDIVISION LOCATED IN PART OF THE NE 1/4 OF THE NE 1/4 OF SECTION 16, TOWN 1 NORTH, RANGE 17 EAST, WALWORTH COUNTY, WISCONSIN

WORK ORDERED BY -NANCY KOZLOWSKI PO BOX 189 MEDINAH, IL 60157

PARK DRIVE

\$50' WIDE R.O.W.}

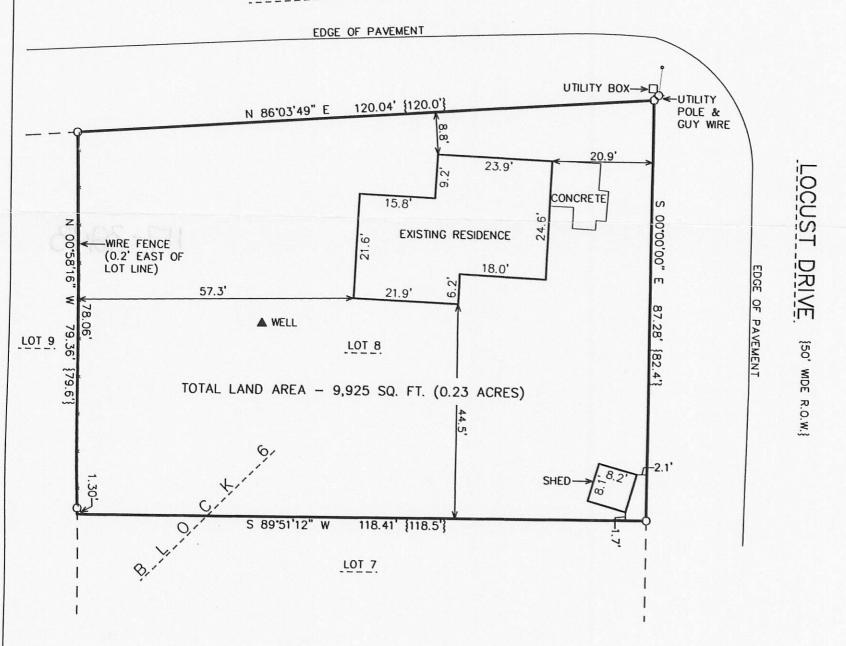

10 5 100 70 80 90 hilling ORIGINAL

NOTE: COPIES OF THIS MAP TO WHICH THE FOLLOWING CERTIFICATE WILL APPLY SHOW THE SURVEYOR'S ORIGINAL SEAL AND SIGNATURE IN RED INK. COPIES BY ANY OTHER MEANS MAY HAVE ALTERATIONS WHICH DO NOT REPRESENT THE SURVEYOR'S WORK PRODUCT.

I HEREBY CERTIFY THAT THE ABOVE DESCRIBED PROPERTY HAS BEEN SURVEYED UNDER MY DIRECTION AND THAT THE ABOVE MAP IS A TRUE REPRESENTATION THEREOF AND SHOWS THE SIZE AND LOCATION OF THE PROPERTY AND ITS EXTERIOR BOUNDARIES. THIS SURVEY IS MADE FOR THE USE OF THE PRESENT OWNERS OF THE PROPERTY, AND ALSO THOSE WHO PURCHASE, MORTGAGE, OR GUARANTEE THE TITLE THERETO WITHIN ONE YEAR FROM THE DATE HEREOF.

DATED: SEPTEMBER 1, 2010


X: \Projects\8223\Dcad\SURVEY\_20100901

PETER S. GORDON R.L.S. 2101

GORDON S-2101 ELKHORN, WI

LEGEND = FOUND IRON PIPE STAKE

{XXX} = RECORDED AS

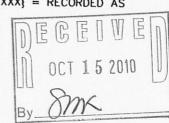

PROJECT: 8223 DATE: 9/1/2010 SHEET 1 OF 1