


PLAT OF SURVEY  
PART OF LOTS 2 & 3 OF CERTIFIED SURVEY MAP NO. 1450  
REC. IN VOL. 6, ON PG. 355  
TOWN OF LINN  
WALWORTH COUNTY, WISCONSIN

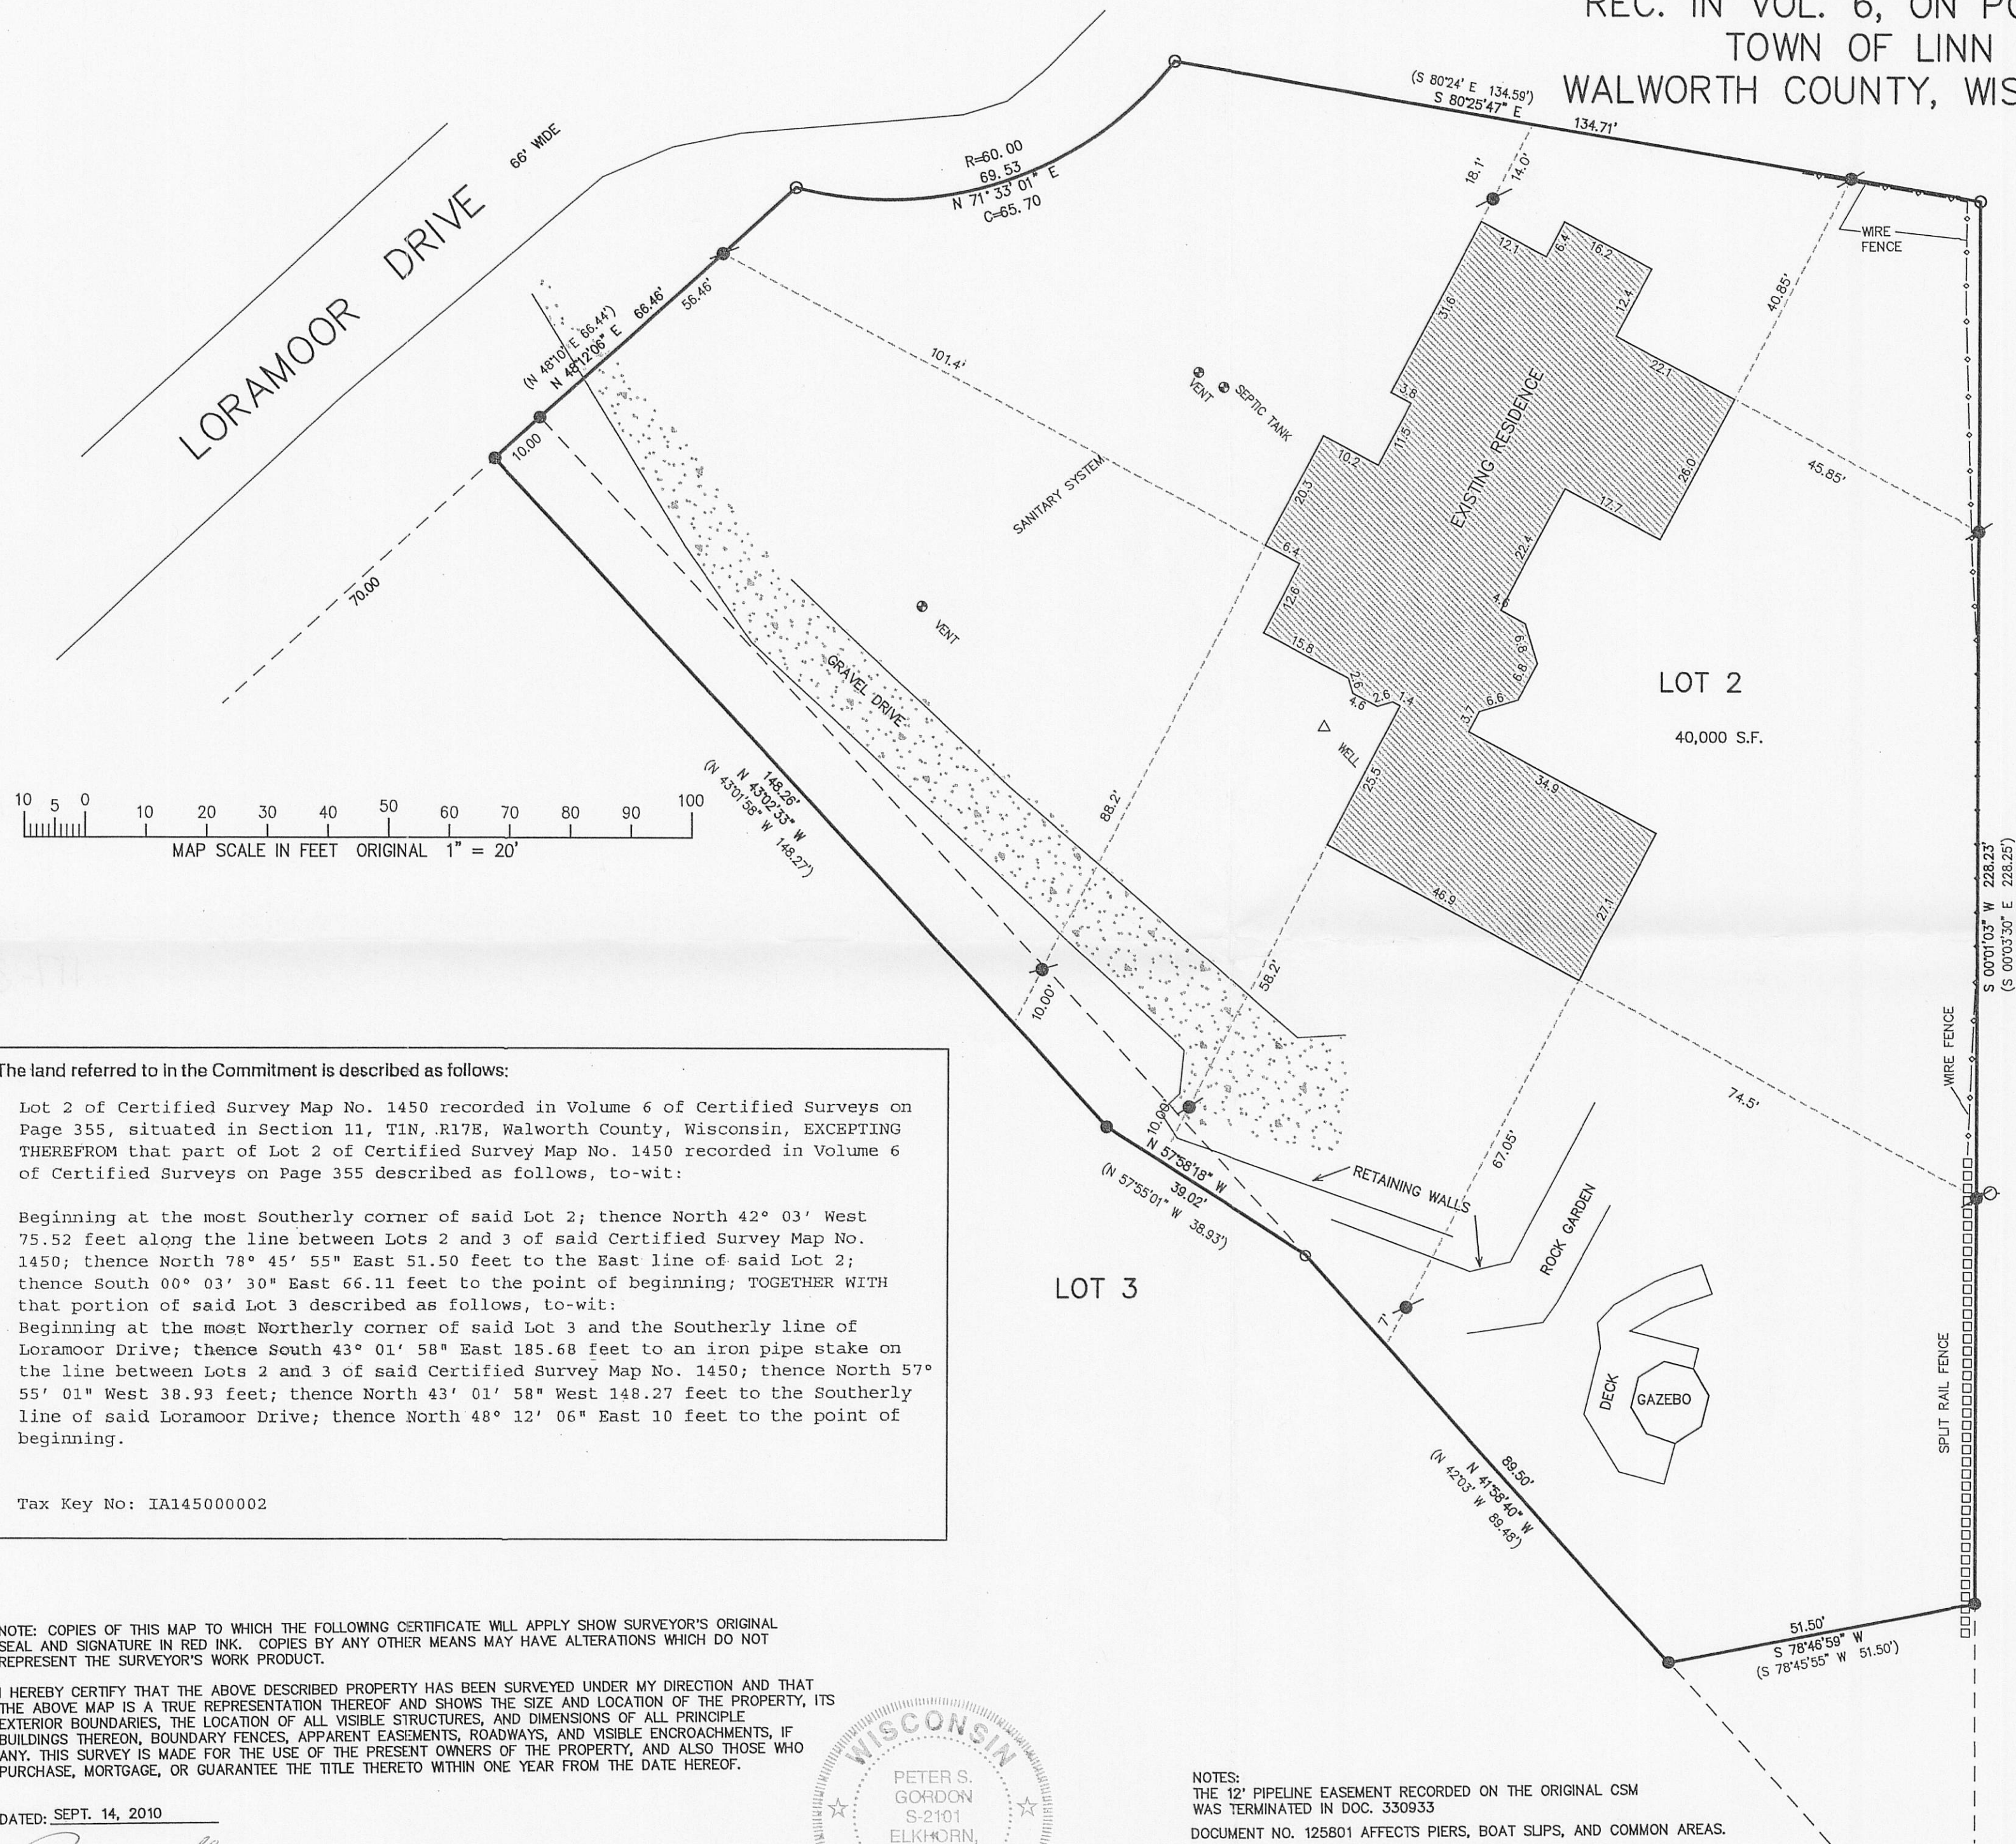

3. The land referred to in the Commitment is described as follows:

Lot 2 of Certified Survey Map No. 1450 recorded in Volume 6 of Certified Surveys on Page 355, situated in Section 11, T1N, R17E, Walworth County, Wisconsin, EXCEPTING THEREFROM that part of Lot 2 of Certified Survey Map No. 1450 recorded in Volume 6 of Certified Surveys on Page 355 described as follows, to-wit:

Beginning at the most Southerly corner of said Lot 2; thence North 42° 03' West 75.52 feet along the line between Lots 2 and 3 of said Certified Survey Map No. 1450; thence North 78° 45' 55" East 51.50 feet to the East line of said Lot 2; thence South 00° 03' 30" East 66.11 feet to the point of beginning; TOGETHER WITH that portion of said Lot 3 described as follows, to-wit:

Beginning at the most Northerly corner of said Lot 3 and the Southerly line of Loramoor Drive; thence South 43° 01' 58" East 185.68 feet to an iron pipe stake on the line between Lots 2 and 3 of said Certified Survey Map No. 1450; thence North 57° 55' 01" West 38.93 feet; thence North 43° 01' 58" West 148.27 feet to the Southerly line of said Loramoor Drive; thence North 48° 12' 06" East 10 feet to the point of beginning.


Tax Key No: IA145000002

NOTE: COPIES OF THIS MAP TO WHICH THE FOLLOWING CERTIFICATE WILL APPLY SHOW SURVEYOR'S ORIGINAL SEAL AND SIGNATURE IN RED INK. COPIES BY ANY OTHER MEANS MAY HAVE ALTERATIONS WHICH DO NOT REPRESENT THE SURVEYOR'S WORK PRODUCT.

I HEREBY CERTIFY THAT THE ABOVE DESCRIBED PROPERTY HAS BEEN SURVEYED UNDER MY DIRECTION AND THAT THE ABOVE MAP IS A TRUE REPRESENTATION THEREOF AND SHOWS THE SIZE AND LOCATION OF THE PROPERTY, ITS EXTERIOR BOUNDARIES, THE LOCATION OF ALL VISIBLE STRUCTURES, AND DIMENSIONS OF ALL PRINCIPLE BUILDINGS THEREON, BOUNDARY FENCES, APPARENT EASEMENTS, ROADWAYS, AND VISIBLE ENCROACHMENTS, IF ANY. THIS SURVEY IS MADE FOR THE USE OF THE PRESENT OWNERS OF THE PROPERTY, AND ALSO THOSE WHO PURCHASE, MORTGAGE, OR GUARANTEE THE TITLE THERETO WITHIN ONE YEAR FROM THE DATE HEREOF.

DATED: SEPT. 14, 2010

*Peter S. Gordon*  
PETER S. GORDON R.L.S. 2101

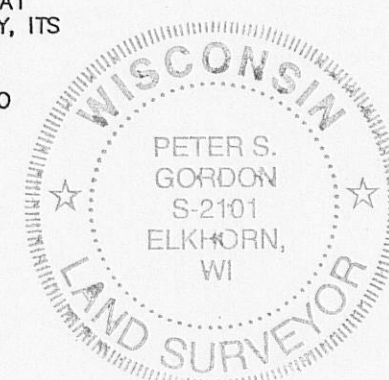

NOTES:  
THE 12' PIPELINE EASEMENT RECORDED ON THE ORIGINAL CSM WAS TERMINATED IN DOC. 330933  
DOCUMENT NO. 125801 AFFECTS PIERS, BOAT SLIPS, AND COMMON AREAS.  
DOC. NO. 125481 AND 128044 AFFECTS LOT 1 OF CSM 1450  
DOC. NO. 126288, 133688, AND 431428 AFFECTS LOT 3 OF CSM 1450 AND DOES NOT AFFECT LOT 2



WORK ORDERED BY:  
REMAX GENEVA REALTY  
101 BROAD STREET SUITE 102  
LAKE GENEVA, WI. 53147

FARRIS, HANSEN & ASSOCIATES, INC.  
ENGINEERING - ARCHITECTURE - SURVEYING  
7 RIDGWAY COURT P.O. BOX 437  
ELKHORN, WISCONSIN 53121  
OFFICE: (262) 723-2098 FAX: (262) 723-5886

REVISIONS

PROJECT NO.  
2267.2.10  
DATE:  
09-14-2010  
SHEET NO.  
1 OF 1

IA1450-2

117.3245