
46-13

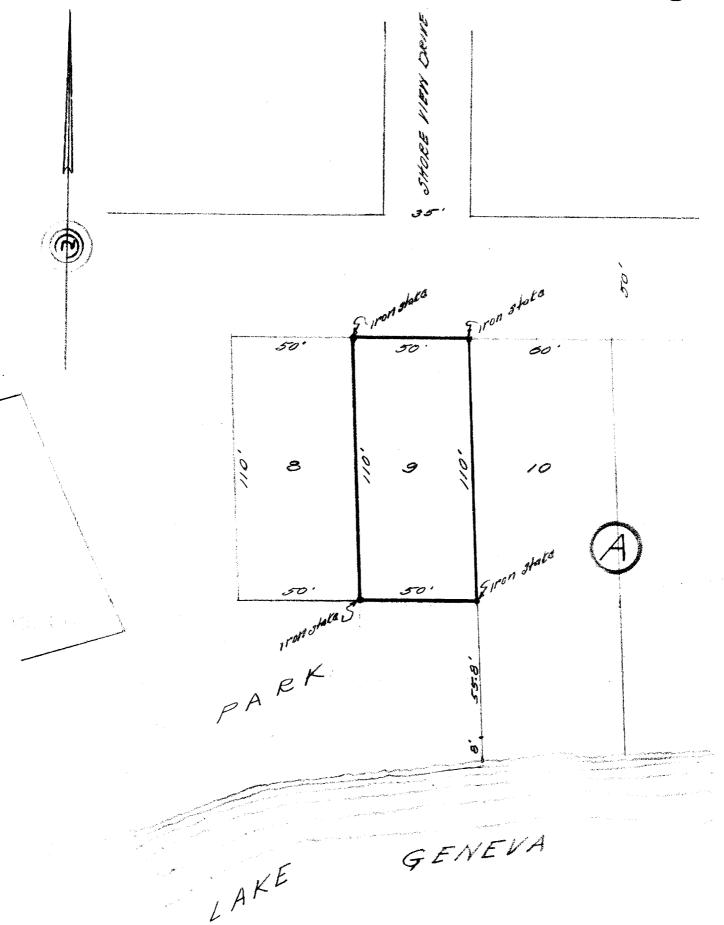

DESCRIPTION: Lot 9 Block & Cisco Beach Subdivision of a portion of the N.E. $\frac{1}{4}$ of Section 5, Township 1 north, Range 17 east of the 4th P.M., Linn Township, Walworth County, Wisconsin.

Certificate: I, hereby certify that I have on this the 3rd day of February, 1946, surveyed the above described property according to the official records on file in the office of the Recorder of Deeds in and for Walworth County, Wisconsin, and find that the measurements and bearings of the boundary lines of said property, as taken on this day substantially agree with those in the above description, and that no encroschments exist.

SIGNED AND SEALED THIS 4TH DAY OF FEBRUARY 1946.

Jøseph M. Biagi. Professional Engineer Elkhorn Wisconsin.

117-326