XXXX-111

PREPARED FOR MARY PETERSON N2327 KNOLLWOOD DR. LAKE GENEVA WI. 53147

PLAT OF SURVEY


-OF-

LOT 8, BLOCK B, AND LOT 7, EXCEPT THE SOUTH 20 FEET THEREOF IN BLOCK B IN CISCO BEACH SUBDIVISION, ACCORDING TO THE RECORD PLAT THEREOF, LOCATED IN SECTION 5, TOWN 1 NORTH, RANGE 17 EAST, WALWORTH COUNTY, WISCONSIN.

SCALE 1'' = 20'

NOTE: BEARINGS ARE REFRENCED TO PREVIOUS SURVEY RECORDS

20

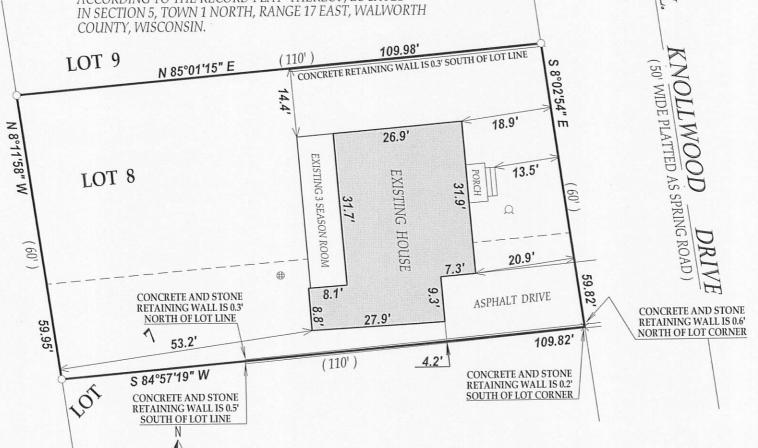

LEGEND

- O FOUND IRON PIPE
- × FOUND CUT CROSS
- Q WELL
- ⊕ SEPTIC COVER

(XX) RECORDED AS TAX ID # ICI00022

JOB # 11-007

I have surveyed the above-described property and the above map is a true representation thereof and shows the size and location of the property, its exterior boundaries, the location and dimensions of all structures thereon, fences apparent easements and roadways and visible encroachments. if any.

This survey is made for the exclusive use of the present owners of the property, and also those who puchase, mortgage, or insure the title therto within one (1) year from date hereof; and as to them I warrant the accuracy of said survey map. KROTT SURVEYING INC.

N3705 WILLOW BEND LANE LAKE GENEVA WI. 53147 PHONE # (262)248-3697 FAX # (262)249-0639



JOHN KROTT S - 2258 Wisconsin Registered Land Surveyor (original if signed in red)

DATED THIS 17th DAY OF JANUARY 2011.

117 2268