PREPARED FOR:
ICON DEVELOPMENT GROUP
JOHN MATUSIK
2413 W. ALGONQUIN RD.
SUITE 247
ALGONQUIN, IL 60102


PLAT OF SURVEY

-OF-

LOT 36 IN ROSS D. SILL'S SUBDIVISION LOCATED IN SECTION 18, TOWN 1 NORTH, RANGE 17 EAST, LINN TOWNSHIP, WALWORTH COUNTY, WISCONSIN.

KROTT SURVEYING INC.

N3705 WILLOW BEND LANE LAKE GENEVA WI. 53147 PHONE # (262)248-3697 FAX # (262)249-0639

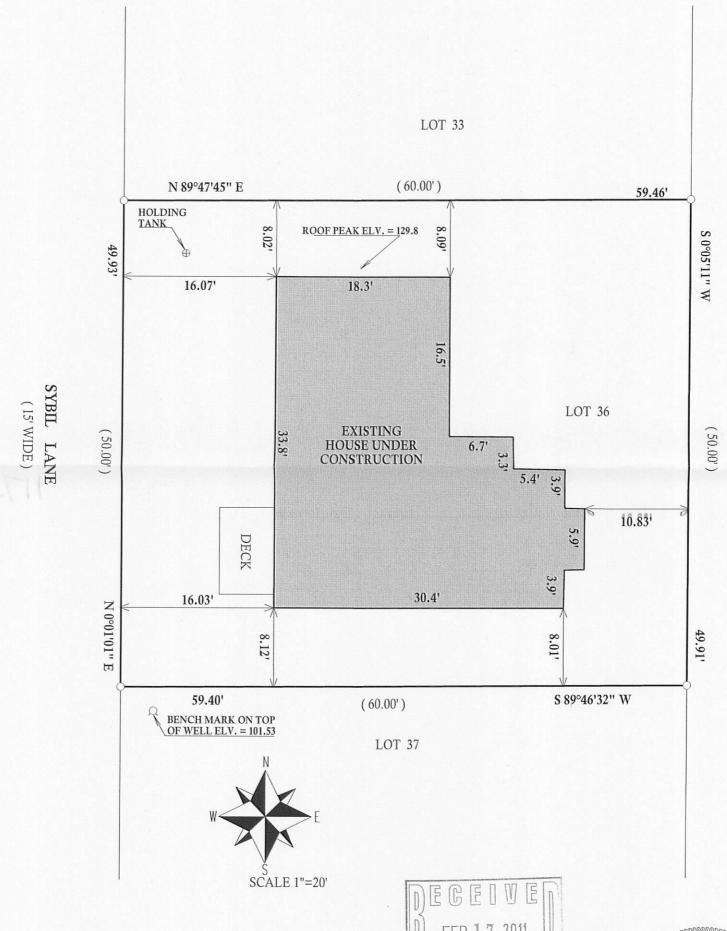

LEGEND

O FOUND IRON PIPE

☐ FOUND IRON BAR

■ SET IRON BAR

(XX) RECORDED AS
TAX ID # ICA00035
JOB # 10-173PEAK

I have surveyed the above-described property and the above map is a true representation thereof and shows the size and location of the property, its exterior boundaries, the location and dimensions of all structures thereon, fences apparent easements and roadways and visible encroachments. if any.

This survey is made for the exclusive use of the present owners of the property, and also those who puchase, mortgage, or insure the title therto within one (1) year from date hereof; and as to them I warrant the accuracy of said survey map.



DATED THIS 18th, DAY OF NOVEMBER, 2010 DATE OF LAST REVISION 01 / 14 / 2011

John Hall

JOHN KROTT S - 2258 Wisconsin Registered Land Surveyor (original if signed in red)