
117-327

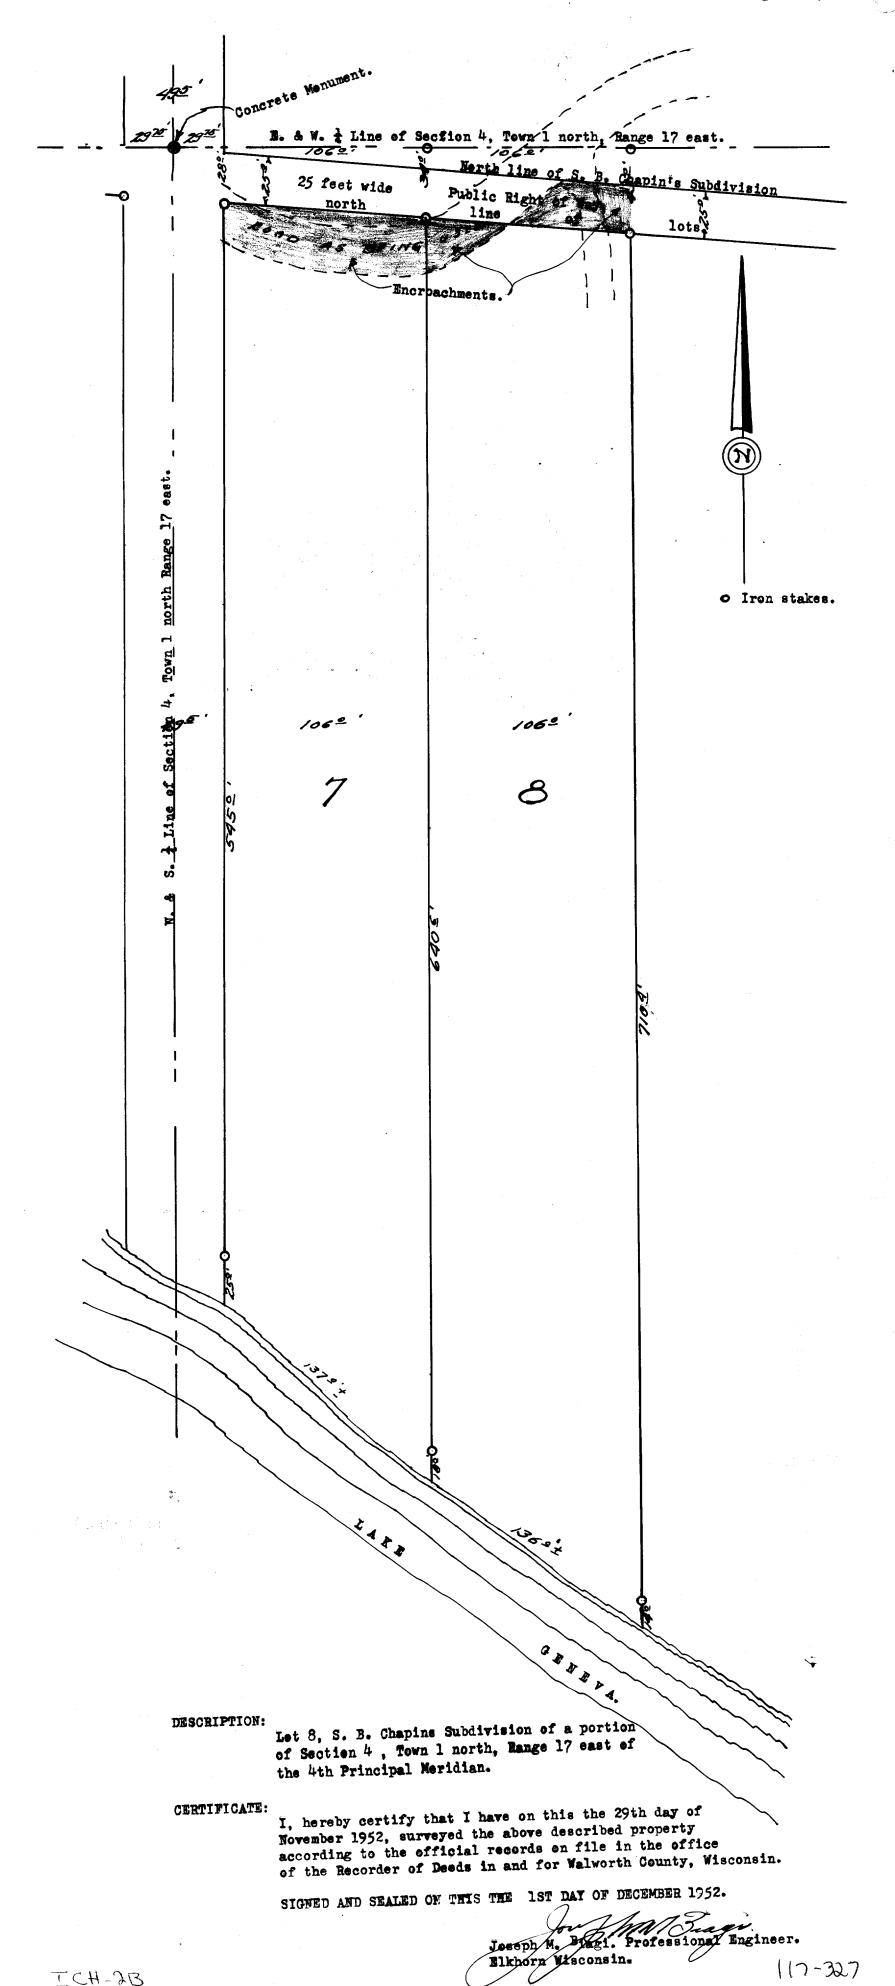

ICH-JB