## LAND-MARK SURVEYING

Mark L. Miritz Wisconsin Registered Land Surveyor S-2582

N9330 Knuteson Drive Whitewater, WI 53190 Phone: (262) 495-3284 FAX(262)495-8421 LAND-MARKSURVEYING.COM

SITE PLAN

LOT 13 AND THE SOUTH 1/2 OF LOT 11, LAKE GENEVA CLUB, LOCATED IN SECTION 18, TOWN 1 NORTH, RANGE 1 EAST, WAL-WORTH COUNTY, WISCONSIN.

**OWNER: LEO F. ALT TRUST** MARY ELLEN ALT TRUST 1306 LAWRENCE **LAKE FOREST, IL 60045** 

22.6 RESIDENCE

NORTH 1/2 OF LOT 11


RESIDESNCE


21.8'

ROADWAY (12.5' WIDE)

STORM SEWER GRATE

THE WEST LINE OF LOT 13 WAS ASSUMED TO BEAR NORTH

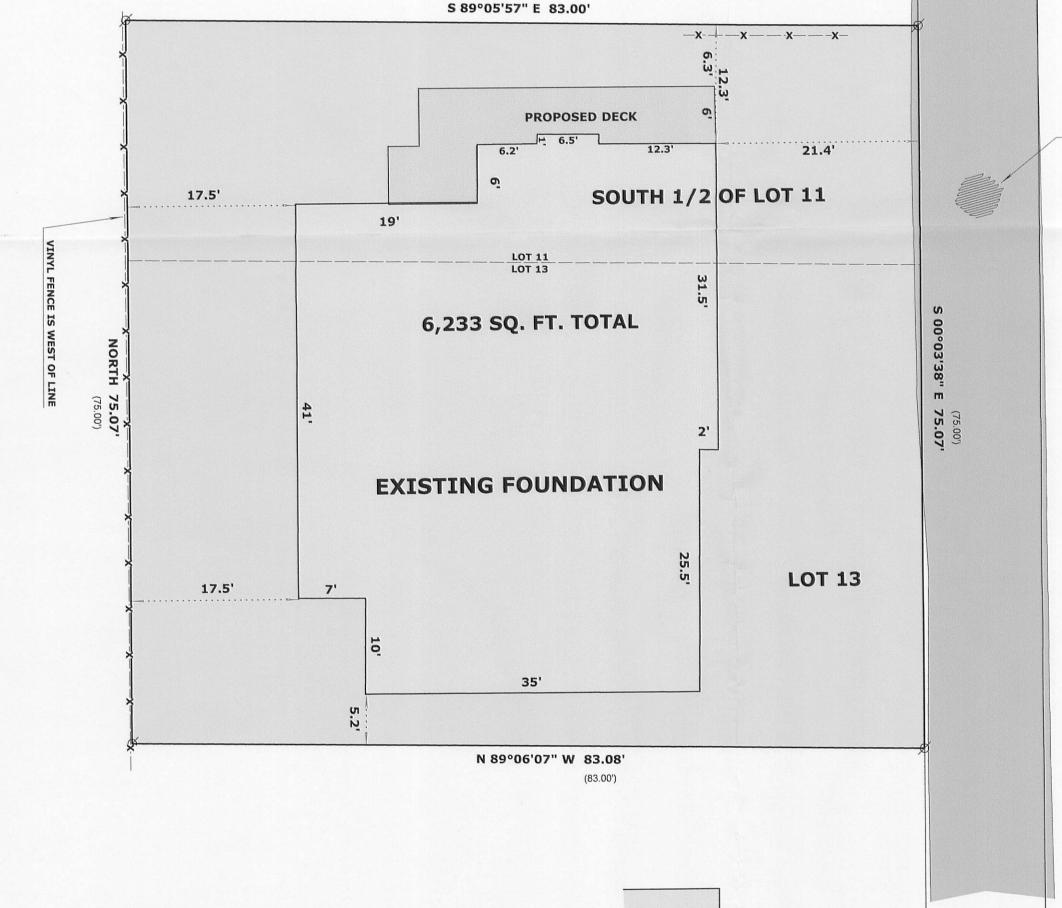

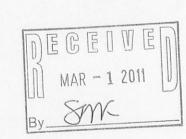

## **LEGEND**

FOUND IRON PIPE ( x x ) RECORDED AS DIMENSION —X—X— EXISTING FENCE

## SCALE: 1 INCH = 10 FEET

"I hereby certify that the above described property has been surveyed by me or under my direction and that the above map is a true representation thereof and shows the size and location of the property, its exterior boundaries, the location of all visible structures and dimensions of all principal buildings thereon, boundary fences, apparent easements, roadways and visible encroachments, if any." "This survey is made for the use of the present owners of the property, and also those who purchase, mortgage, or guarantee the title thereto within one year from date hereof."

MARK L. MIRITZ WISCONSIN REGISTERED

MAY 7, 2010 DATE:\_

**LAND SURVEYOR S-2582** JOB NO.\_\_\_\_\_\_10.504



REVISED NOV. 24, 2010 TO SHOW FOUNDATION "AS BUILT"