PREPARED FOR HUMMEL CONSTRUCTION N1958 SOUTH 2nd ST. DELAVAN WI. 53115


PLAT OF SURVEY

KROTT SURVEYING INC.

N3705 WILLOW BEND LANE LAKE GENEVA WI. 53147 PHONE # (262)248-3697 FAX # (262)249-0639

-OF-

LOT 15 OF LAKE GENEVA CLUB , BEING LOCATED IN LOT NO. 3 OF THE NORTH 1/2 OF THE FRACTIONAL SECTION 18, TOWN 1 NORTH , RANGE 17 EAST, WALWORTH COUNTY, WISCONSIN.

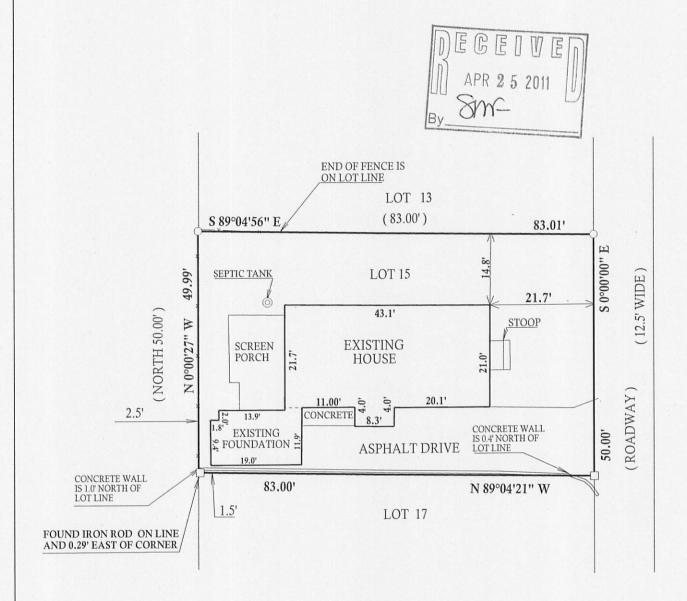



SCALE 1"=20'


LEGEND

- O FOUND IRON PIPE
- FOUND IRON BAR
- SET IRON BAR

(XX) RECORDED AS

JOB # 10-101 TAX ID #1LGC00013 I have surveyed the above-described property and the above map is a true representation thereof and shows the size and location of the property, its exterior boundaries, the location and dimensions of all structures thereon, fences apparent easements and roadways and visible encroachments. if any.

This survey is made for the exclusive use of the present owners of the property, and also those who puchase, mortgage, or insure the title therto within one (1) year from date hereof; and as to them I warrant the accuracy of said survey map.

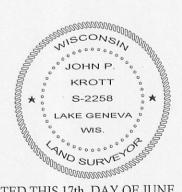

DATED THIS 17th, DAY OF JUNE, 2010 DATE OF LAST REVISION 04 / 13 / 2011

JOHN KROTT S - 2258
Wicconsin Registered Land Surveyor

Wisconsin Registered Land Surveyor (original if signed in red)