


45-13

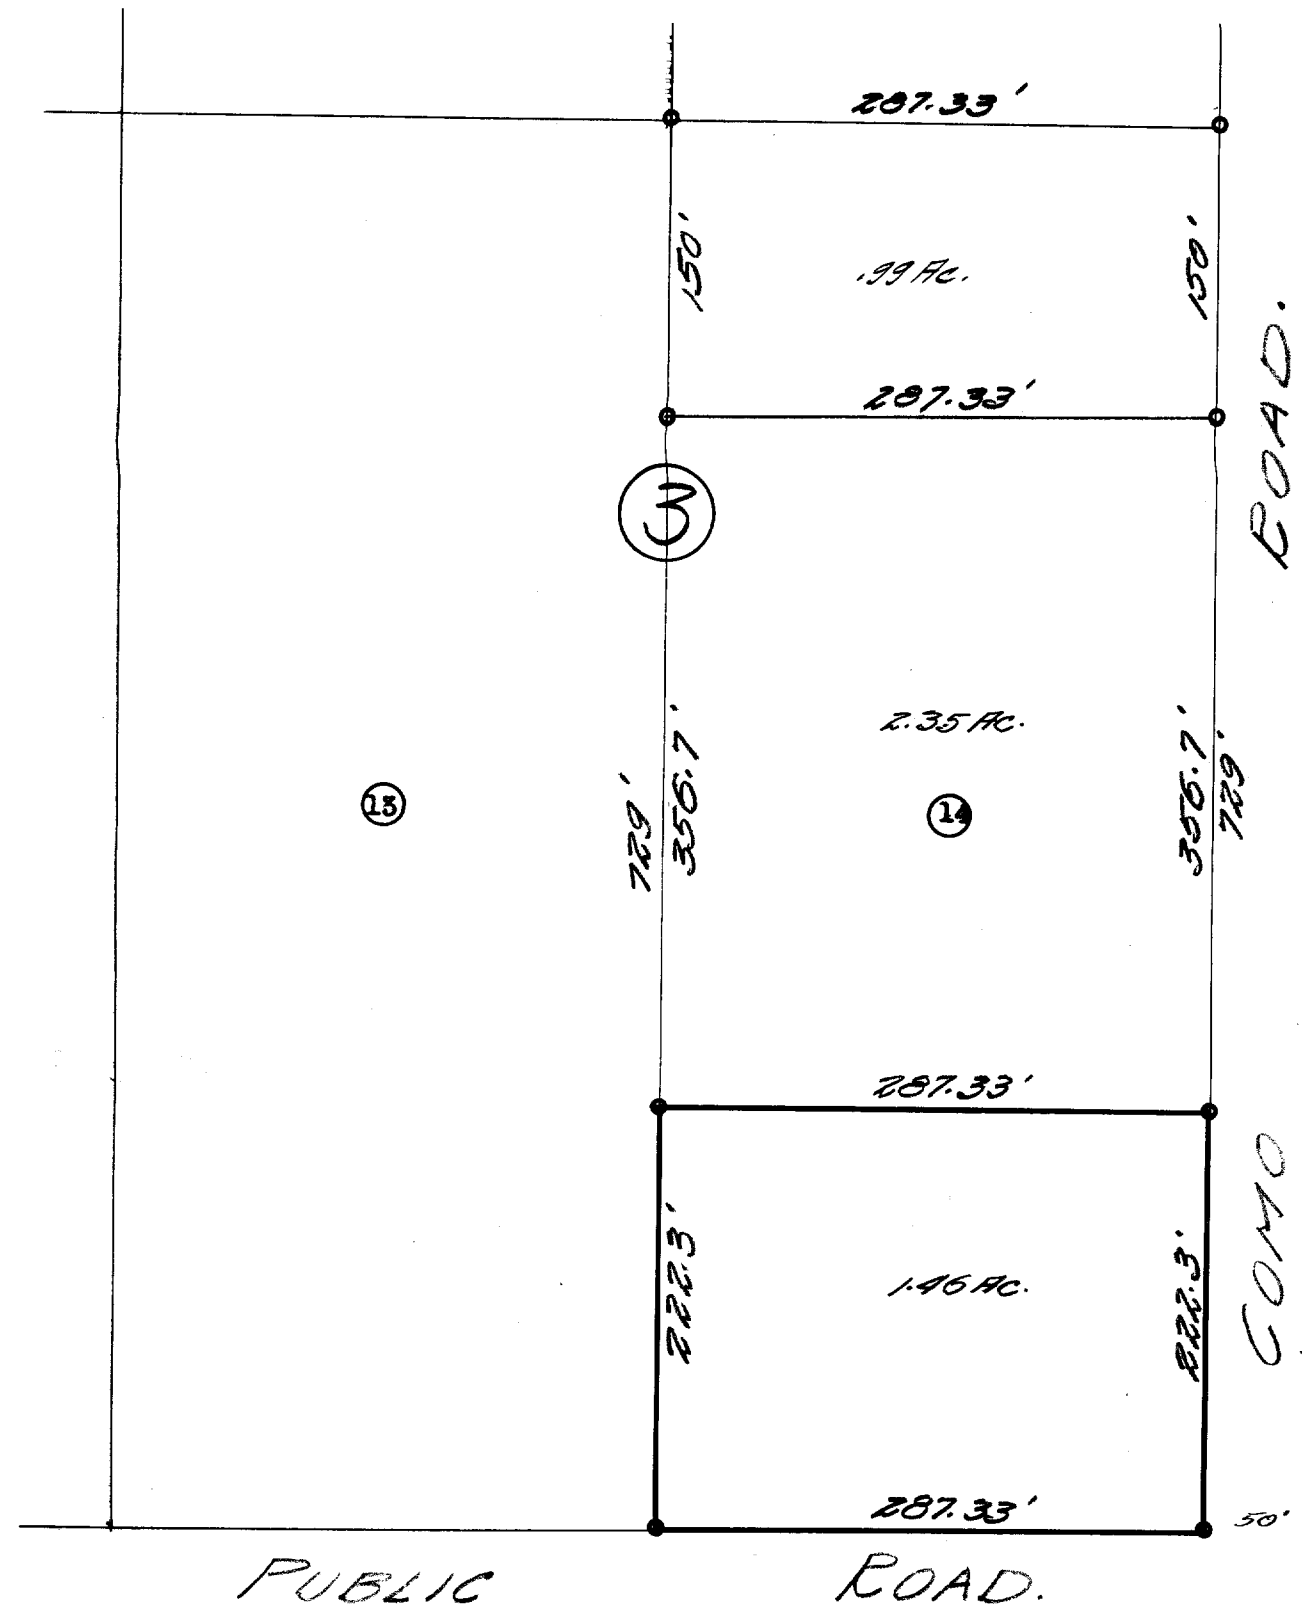

0 - Iron Stakes

DESCRIPTION: The South 222.3 feet of Lot 14 Block 3 Rewena Park a subdivision of a part of fractional Section 5, Township 1 north, Range 17 East of the 4th Principal Meridian.
 CERTIFICATE: I, hereby certify that I have on this the 15th day of September, surveyed the above described property according to the official records on file in the Office of the Recorder of Deeds in and for Walworth County Wisconsin, and find that no encroachments exist.
 SIGNED AND SEALED THIS 24TH DAY OF SEPTEMBER 1945.

IRP-42

Joseph M. Biagi
 Joseph M. Biagi. Professional Engineer.
 Elkhorn Wisconsin.

117-328