
PREPARED FOR ICON DEVELOPMENT GROUP 2413 W. ALGONQUIN RD. SUITE 247 ALGONQUIN, IL 60102

PLAT OF SURVEY

-OF-

UNIT 15 OF SOUTHSHORE CLUB ON LAKE GENEVA A CONDOMINIUM BEING A REPLAT OF NORTHWESTERN ESTATES A CONDOMINIUM LOCATED IN CERTIFIED SURVEY MAP 2631 RECORDED IN VOLUME 13 OF CERTIFIED SURVEYS ON PAGE 171, AS DOCUMENT NUMBER 311927 BEING IN ALL 1/4'S OF NE 1/4 OF SECTION 18 TOWN 1 NORTH, RANGE 17 EAST, WALWORTH COUNTY, WISCONSIN. KROTT SURVEYING INC.

N3705 WILLOW BEND LANE LAKE GENEVA WI. 53147 PHONE # (262)248-3697 FAX # (262)240-0639

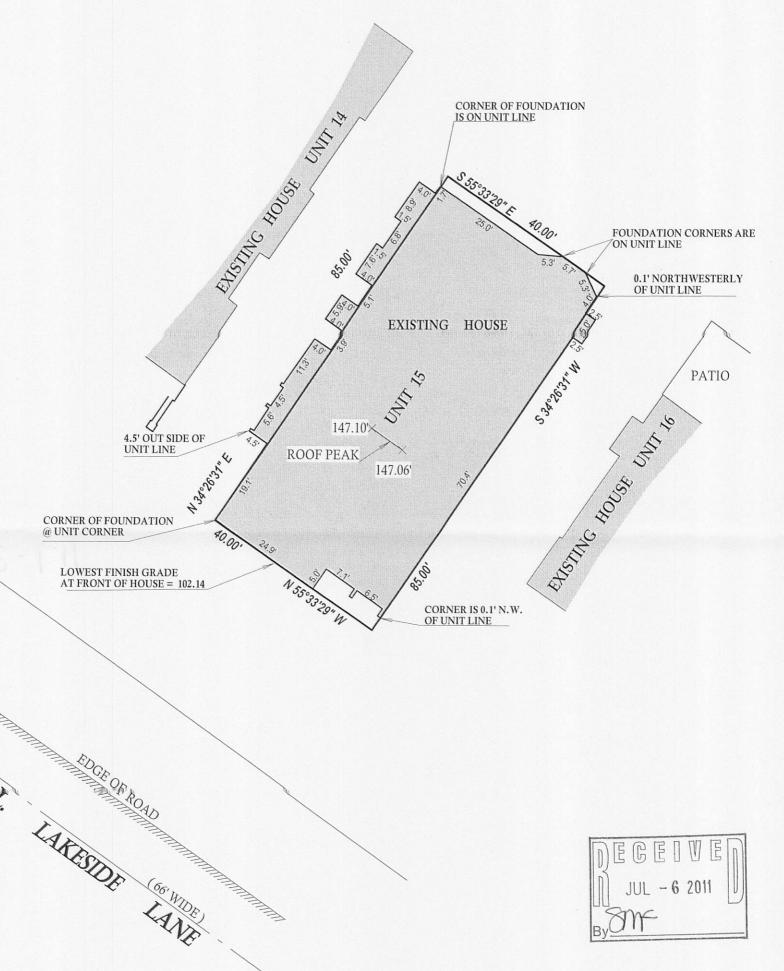


SCALE 1" = 20'

SCALE 1" = 20'

Library surround the allow down in the state of the

I have surveyed the above-described property and the above map is a true representation thereof and shows the size and location of the property, its exterior boundaries, the location and dimensions of all structures thereon, fences apparent easements and roadways and visible encroachments. if any.

This survey is made for the exclusive use of the present owners of the property, and also those who puchase, mortgage, or insure the title therto within one (1) year from date hereof; and as to them I warrant the accuracy of said survey map.

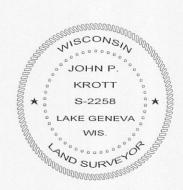

DATE OF LAST REVISION: 6 / 10 / 2011
DATED THIS 29th, DAY OF DECEMBER, 2010.

John Plhoth

JOHN KROTT S - 2258 Wisconsin Registered Land Surveyor (original if signed in red)

