PREPARED FOR: STEVE BERGHOLTZ P.O. BOX 72 WALWORTH WI 53184


PLAT OF SURVEY

-OF-

KROTT SURVEYING INC.

N3705 WILLOW BEND LANE LAKE GENEVA WI. 53147 PHONE # (262)248-3697 FAX # (262)249-0639

LOT 12 OF WOODSTONE, A SUBDIVISION LOCATED IN THE NORTHWEST 1/4 OF THE NORTHEAST 1/4 AND PART OF THE SOUTHWEST 1/4 AND SOUTHEAST 1/4 OF THE NORTHEAST 1/4 OF SECTION 16, TOWN 1 NORTH, RANGE 17 EAST OF THE FOURTH PRINCIPAL MERIDIAN, LYING AND BEING IN THE TOWN OF LINN, COUNTY OF WALWORTH, STAE OF WISCONSIN.

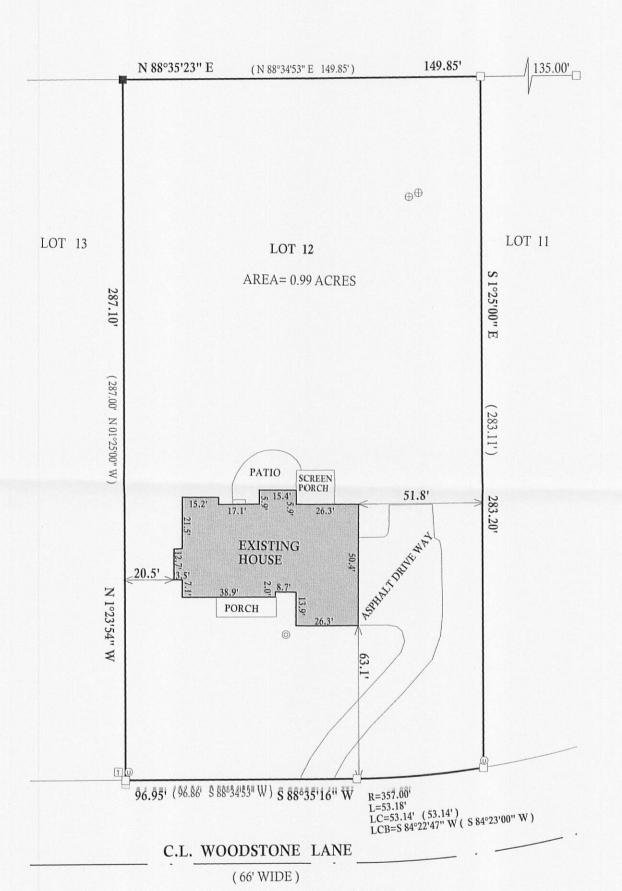

LEGEND

UTILITY PEDESTAL

© WELL

⊕ CONCRETE ACCESS COVER

TRANSFORMER

O FOUND IRON PIPE

☐ FOUND IRON BAR

SET IRON BAR

(XX) RECORDED AS


JOB #11-092

TAX ID # IWO 00012

BEARIINGS REFERENCED TO THE RECORD PLAT OF WOODSTONE



SCALE 1'' = 40'

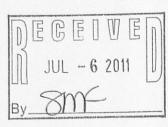

I have surveyed the above-described property and the above map is a true representation thereof and shows the size and location of the property, its exterior boundaries, the location and dimensions of all structures thereon, fences apparent casements and roadways and visible encroachments. if any.

This survey is made for the exclusive use of the present owners of the property, and also those who puchase, mortgage, or insure the title therto within one (1) year from date hereof; and as to them I warrant the accuracy of said survey map.



DATED THIS 14th, DAY OF JUNE, 2011

John Philo

JOHN KROTT S - 2258 Wisconsin Registered Land Surveyor (original if signed in red)