PLAT OF

Certified Survey Number 20, located in the Northwest & of Section 5, T 1 N. R. 17 E. Walworth. County, Wisconsin.





SCALE: 1"= 60"


LEGEND

# - IRON PIPE FOUND

- IRON PIPE PLACED - CONCRETE MONUMENT

X - SPHE

() - AS RECORDED

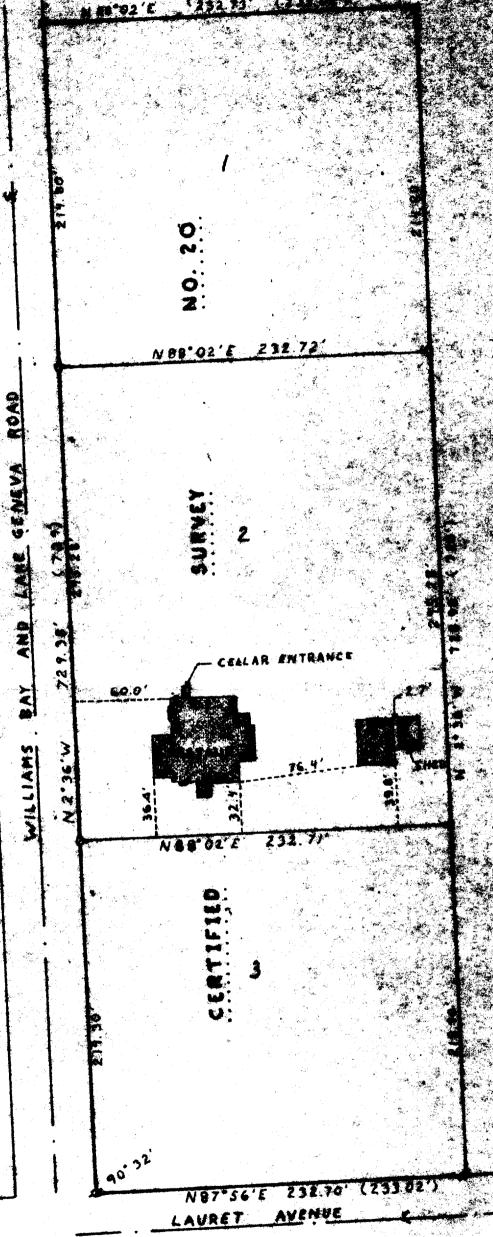

I, HAROLD H. KOLB, DO HERRY GERTIFY THAT I HEN SUBVEYED THE PROPERTY HEREON DESCRIPTION THE OFFICIAL RECURDS, AND THAT YOU PLAT I the principle lines of the buildings thereon IS A COMMECT MEPRESSIVATION OF THE LOT LA

WINCOMEN RESISTENCE LAND BURNETON; & ST. 1910 BATE NOVEMBER 8, 1972