


PLAT OF SURVEY

LOT 13, BLOCK "A" OF CISCO BEACH SUBDIVISION,
LOCATED IN SECTION 5, TOWN 1 NORTH, RANGE 17
EAST, LINN TOWNSHIP, WALWORTH COUNTY, WISCONSIN

OWNER: CATHERINE E. CARPENTER
400 CLARK STREET
EVANSTON, IL 60201

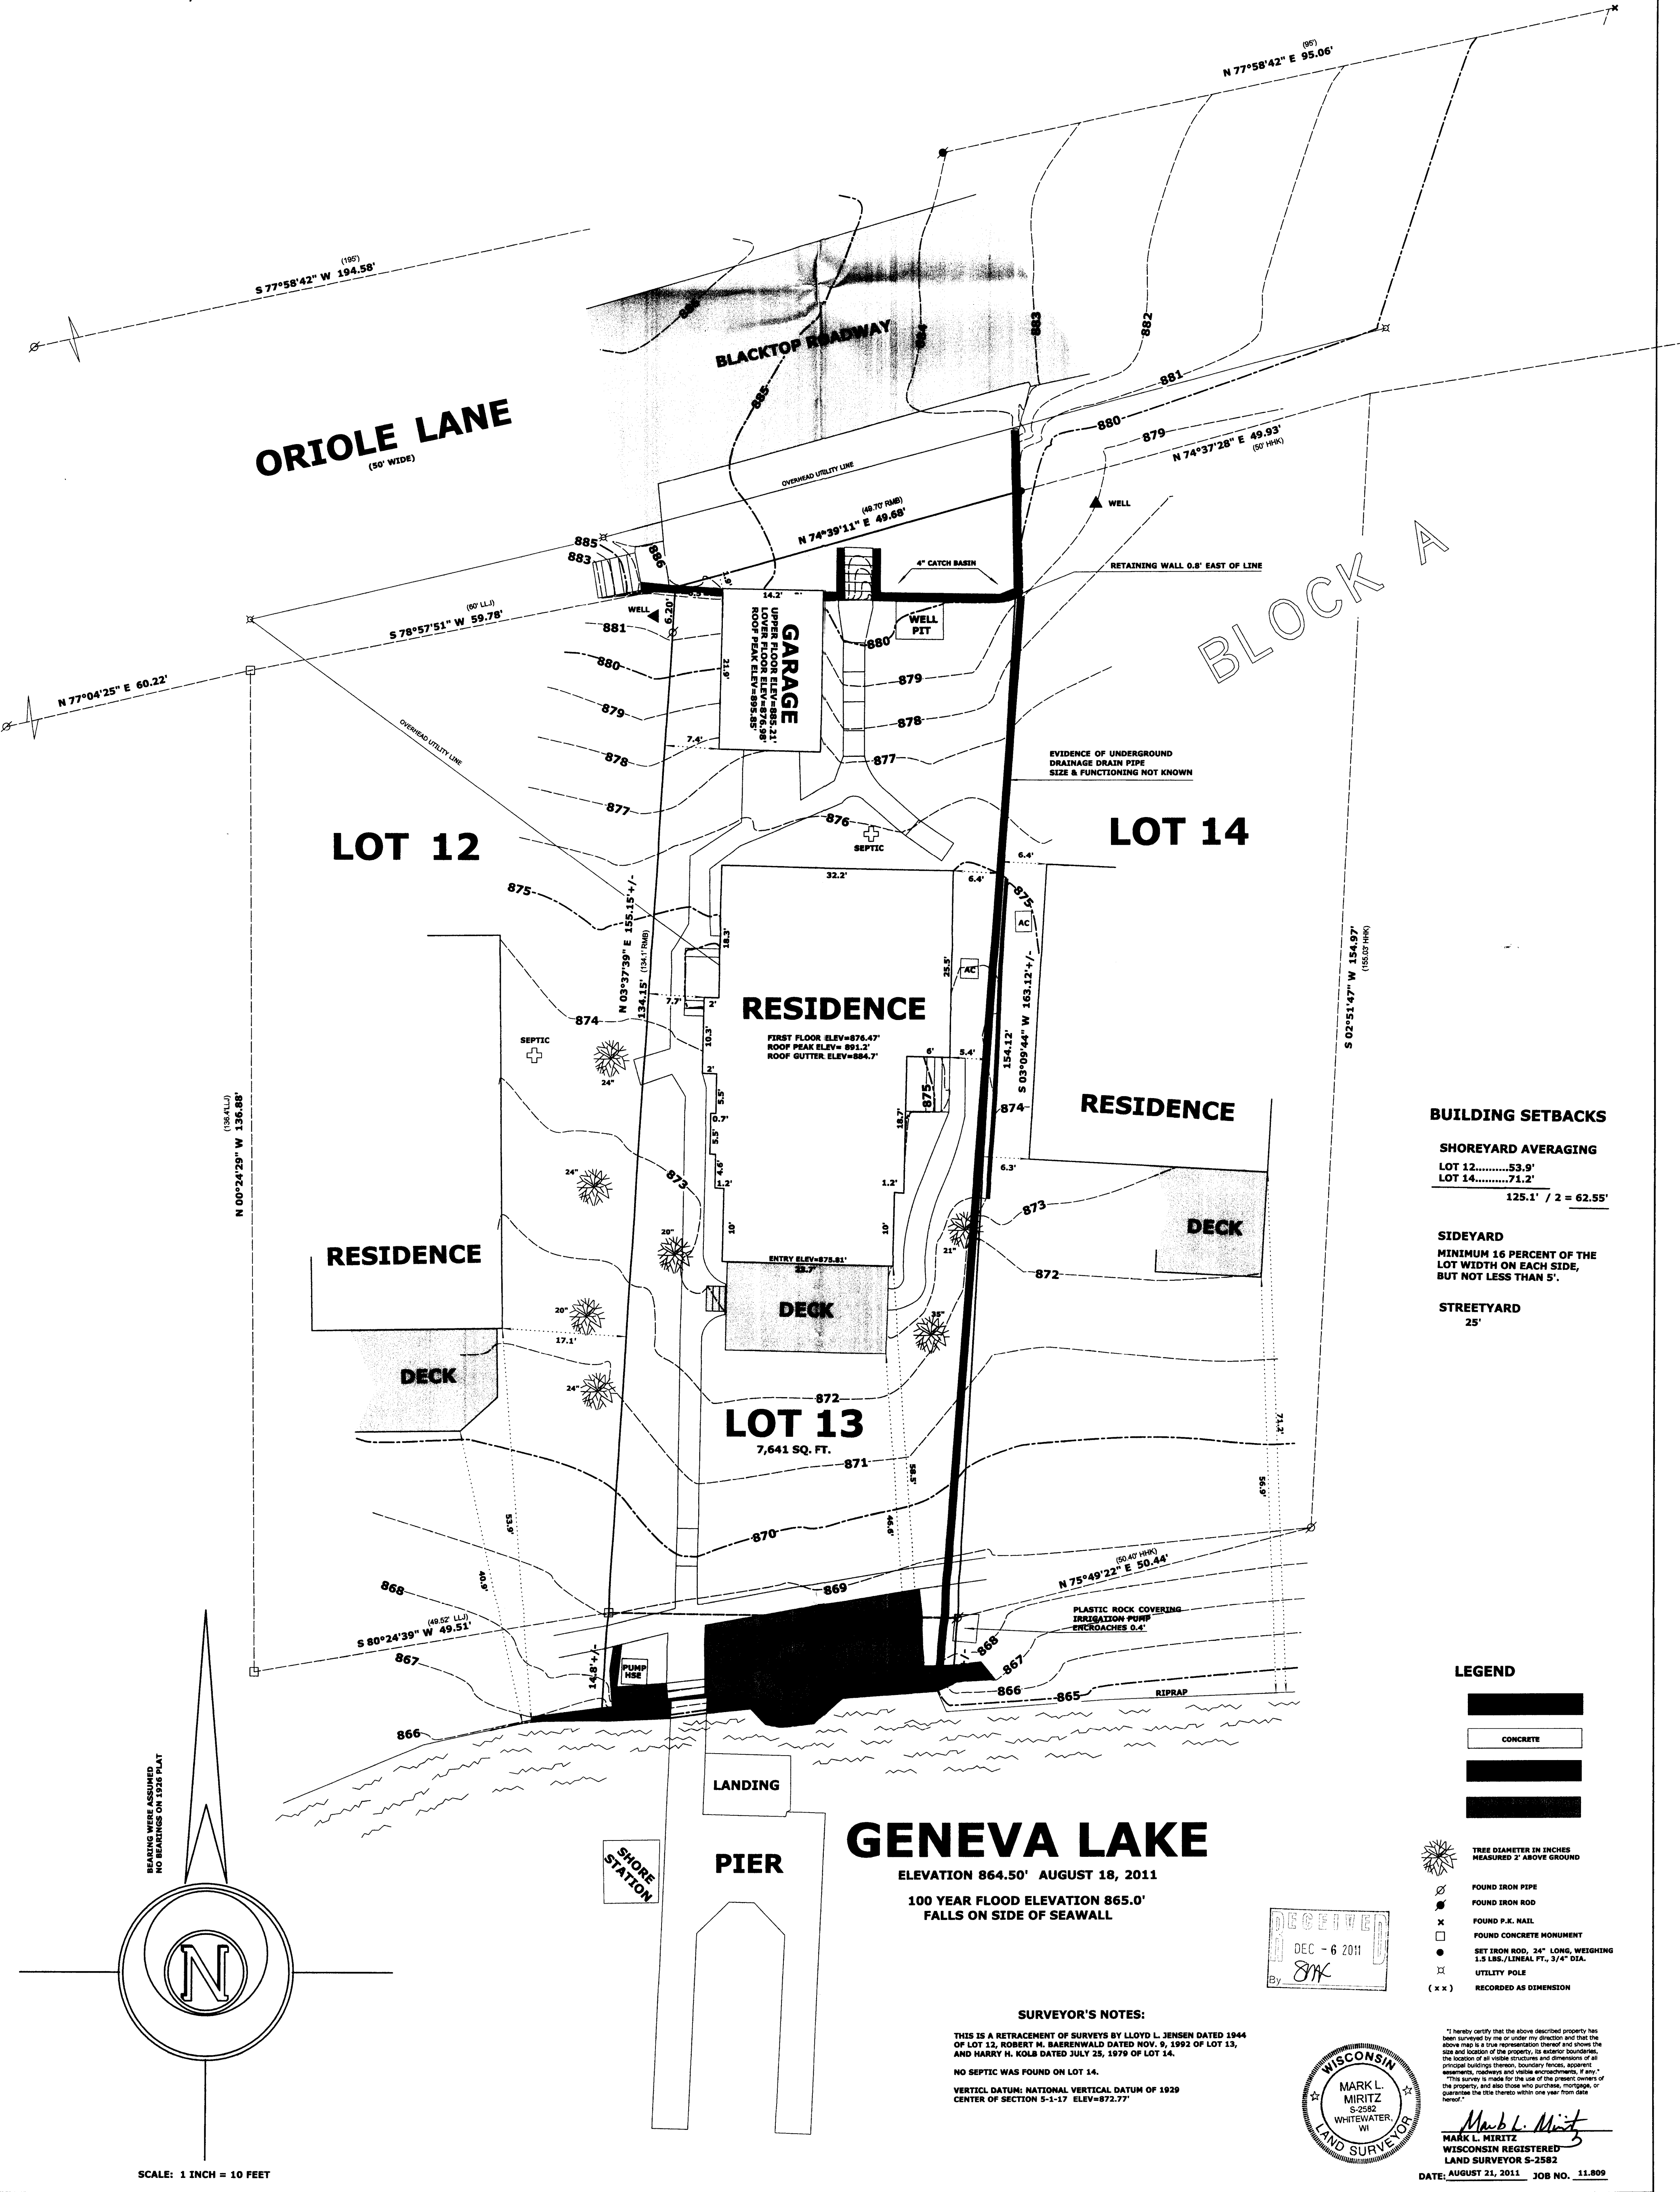

ICI-12

117.3353