


of  
**A Proposed Septic Easement**  
on

Surveyed for: **Shirley W. Ryan Trust**  
150 North Michigan Avenue  
Suite 2100  
Chicago, Illinois. 60601

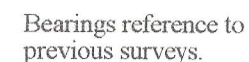

An easement for a septic tank, mound system and force main on a portion of Tax Parcel IF 00005A, being a part of Lot 1 of The Folly, a subdivision located in the Southwest 1/4 of Section 3, Town N, Range 17 East, Town of Linn, Walworth County, Wisconsin, described as follows: Commence at an iron rail at the Northeast Corner of said Lot 1 of The Folly; thence South 0°23'20" West, along the East line of said Lot 1, 638.26 feet to an iron rod at the Northeast Corner of said Tax Parcel IF 00005A; thence continue South 0°23'20" West, along said East line of Lot 1, 161.91 feet to the Point of Beginning; thence continue South 0°23'20" West, along said East line of Lot 1, 15.14 feet; thence South 19°40'00" West 78.72 feet; thence East 6.00 feet; thence South 55.00 feet; thence West 14.00 feet; thence South 3°00'00" West 12.12 feet; thence North 79°00'00" West 17.70 feet; thence North 31°30'00" West 79.29 feet; thence North 40°30'00" West 45.94 feet; thence West 14.04 feet to an iron pipe on the West line of said Tax Parcel IF 00005A; thence North 0°58'02" West, along said West line, 94.88 feet; thence East 35.00 feet; thence South 2°04'00" West 94.93 feet; thence West 9.38 feet; thence South 40°30'00" East 42.06 feet; thence North 31°30'00" West 77.48 feet; thence South 79°00'00" East 9.75 feet; thence North 3°00'00" East 6.10 feet; thence West 10.99 feet; thence North 55.00 feet; thence East 18.69 feet; thence North 19°40'00" East 94.80 feet to the Point of Beginning.


A 15 foot wide easement for access to a septic tank on a portion of Tax Parcel IF 00005A, being a part of Lot 1 of The Folly, a subdivision located in the Southwest 1/4 of Section 3, Township 1 North, Range 17 East, Town of Linn, Walworth County, Wisconsin, described as follows: Commence at an iron nail at the Northeast Corner of said Lot 1 of The Folly, thence South 02°32'20" West, along the East line of said Lot 1, 638.26 feet to an iron nail at the Northeast Corner of said Tax Parcel IF 00005A; thence continue South 02°32'20" West, along said East line of Lot 1, 177.05 feet; thence South 19°40'00" West 78.72 feet, thence East 6.00 feet; thence South 55.00 feet to the Southeast corner of a septic area easement and the Point of Beginning; thence South 6°00'00" West 56.79 feet to a point on the South line of said Tax Parcel IF 00005A; thence South 72°37'40" West, along said South line, 16.34 feet; thence North 6°00'00" East 61.69 feet; thence East, along the South line of a septic area easement, 15.08 feet to the Point of Beginning.



- 1) This survey plat is not certified unless signed and sealed in red ink.
- 2) This survey is subject to Wisconsin lien laws. This Plat of Survey is the notice of intent to file lien. Lien waiver required.

All rights reserved. No part of this survey plat may be reproduced or transmitted in any form by any means - graphic, electronic, or mechanical, including photocopying, tracing, or information storage and retrieval systems - without permission in writing from Douglas G. Olson, Jensen & Olson Land Surveying, LLC.

Douglas G. Olson  
Wisconsin Registered Land Surveyor - 2093

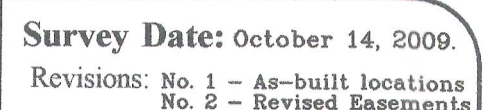

1.041 Acres  
45,366 Sq.Ft.

L o t  
T h e



45 South Wisconsin Street \* P.O. Box 322 \* Elkhorn, Wisconsin. 53121  
Telephone: (262) 723-3434 \* Facsimile: (262) 723-8044  
Email: [jensen.olson@elknet.net](mailto:jensen.olson@elknet.net)

Drawing Name: tlnrl7e-2011056-2011056Exhibit.scj

**Job Reference Number**  
**2011.056**

■ Found Iron Rail  
 ∅ Found Iron Pipe  
 ● Found Iron Rod  
 ( ) Recorded Information  
 ○ PVC Pipe      ☒ Electric Box  
 ○ Concrete Cover  
 ■ Asphalt Surface  
 ■ Concrete Surface

RECEIVED  
FEB 2 2012  
By *SMF*

IF-5A

117-3367