
## PLAT OF SURVEY -OF-

LOT 22, IN BLOCK 3, IN LAKE GENEVA TERRACE, ACCORDING TO THE RECORDED PLAT THEREOF. SAID LAND BEING IN THE TOWN OF LINN, COUNTY OF WALWORTH, STATE OF WISCONSIN.

SURVEY ADDRESS: N1616 WASHINGTON AVENUE

SURVEY FOR: HOMESTEAD REALTY

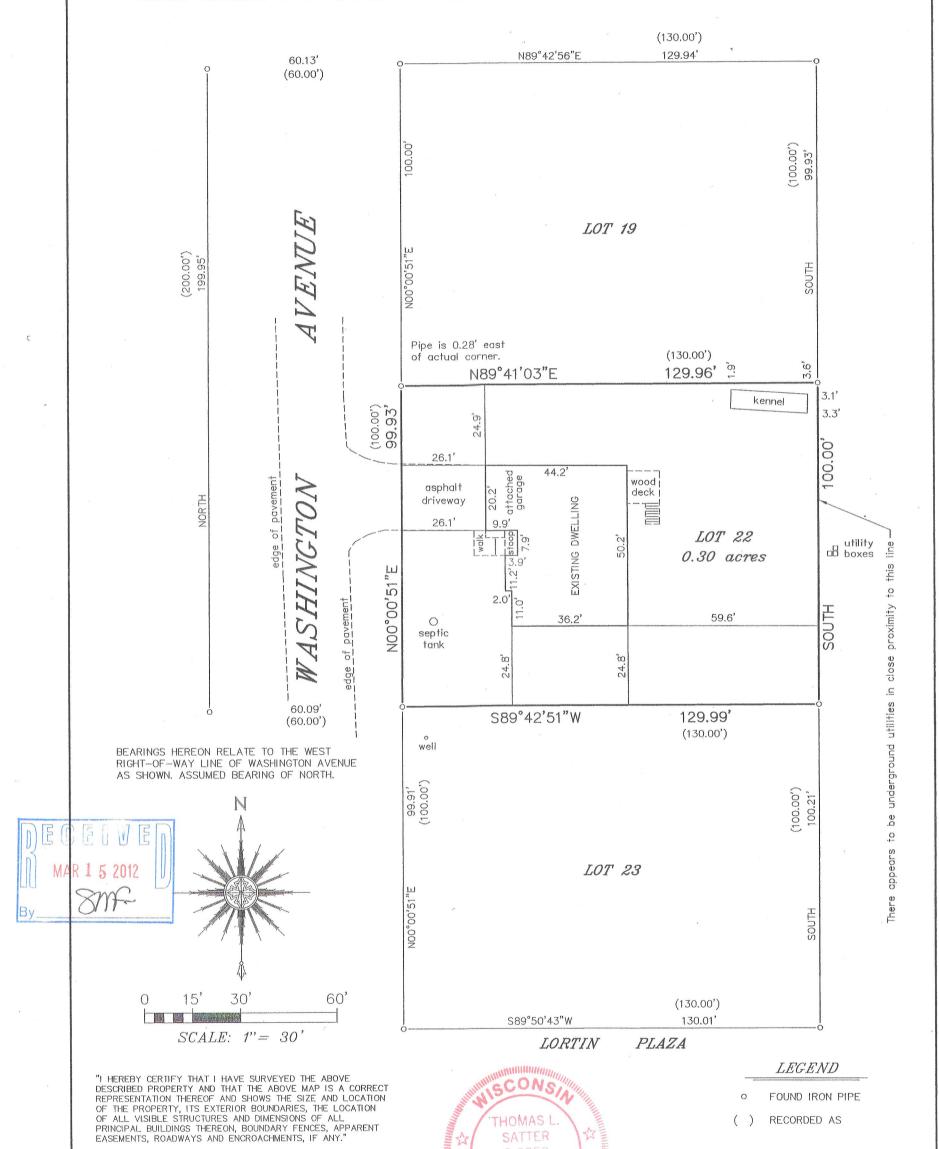

"THIS SURVEY IS MADE FOR THE USE OF THE PRESENT OWNERS OF THE PROPERTY, AND THOSE WHO PURCHASE, MORTGAGE, OR GUARANTEE THE TITLE THERETO WITHIN ONE YEAR FROM DATE SATTER SURVEYING, LLC

LAND SURVEYS, MAPPING AND PLANNING 272 ORIGEN STREET

BURLINGTON, WI 53105 262-661-4239

THIS IS NOT AN ORIGINAL PRINT UNLESS THIS SEAL IS RED.

021205 JOB NUMBER

"Innomment

BURLINGTON, WI

SUR

FEBRUARY 24, 2012 DATE