
PREPARED FOR: TOM MANION 444 ARGYLE ELMHURST IL 60126

PLAT OF SURVEY

KROTT SURVEYING INC. N3705 WILLOWBEND LANE LAKE GENEVA, WI, 53147 262-248-3697

- OF -

LOTS 18 AND 19 IN THE BIRCHES SECOND ADDITION, LOCATED IN SECTION 10, T.1.N., R.17.E., WALWORTH COUNTY, WISCONSIN.

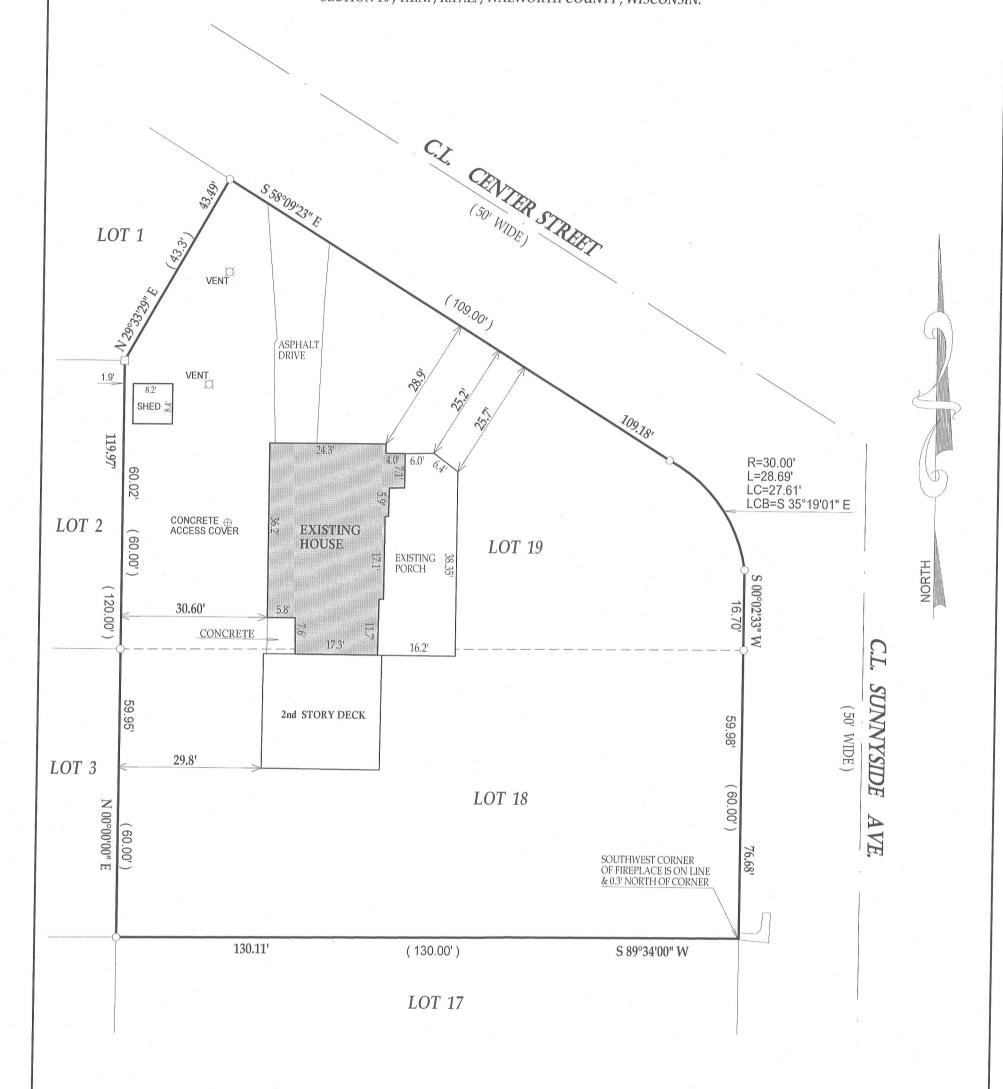

()= recorded as

- = found iron bar
- = found iron pipe
- = set iron pipe
- = set iron bar

SCALE 1" = 20'

JOB # 06-152AB

TAX ID # IBA200003



I have surveyed the above-described property and the above map is a true representation thereof and shows the size and location of the property, its exterior boundaries, the location and dimensions of all structures thereon, fences apparent easements and roadways and visible encroachments. if any.

This survey is made for the exclusive use of the present owners of the property, and also those who puchase, mortgage,or insure the title therto within one (1) year from date hereof; and as to them I warrant the accuracy of said survey map.



DATED THIS 11th, DAY OF APRIL, 2012

JOHN KROTT S - 2258 Wisconsin Registered Land Surveyor (original if signed in red)