


**REGISTERED PROFESSIONAL LAND SURVEYOR  
LAKE GENEVA, WISCONSIN**



♠ - IRON PIPE FOUND  
 ○ - IRON PIPE PLACED  
 ■ - IRON ROD FOUND  
 x - SPIKE  
 ( ) - AS PLATTED

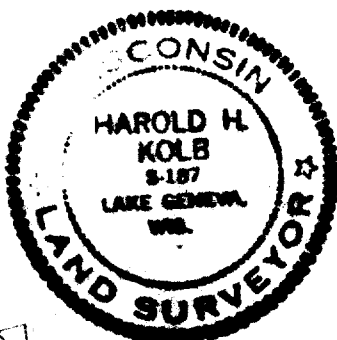

Lot 110, Lake Geneva Highlands, T 1 N,  
R 17 E, Walworth County, Wisconsin.

**I. HAROLD H. KOLE, DO HEREBY CERTIFY THAT I HAVE SURVEYED THE PROPERTY HEREON DESCRIBED ACCORDING TO THE OFFICIAL RECORDS, AND THAT THE PLAT HEREON IS A CORRECT REPRESENTATION OF THE LOT LINES.**

Harold H. Kalk

HAROLD H. KOLB  
WISCONSIN REGISTERED LAND SURVEYOR, S-187  
DATE October 27, 1972

117-339