PREPARED FOR R.J. AMANN BUILDERS 2492 CREST DR. LAKE GENEVA WI. 53147.

## PLAT OF SURVEY


-OF-

LOT 27 OF LAKE GENEVA HIGHLANDS, A SUBDIVISION LOCATED IN SECTION 8, TOWN 1 NORTH, RANGE 17 EAST, WALWORTH COUNTY, WISCONSIN. KROTT SURVEYING INC. N3705 WILLOW BEND LANE LAKE GENEVA WI. 53147 PHONE # (262)248-3697 FAX # (262)249-0639

(50' WIDE

C.L. LAKEVIEW ROAD

(50' WIDE)

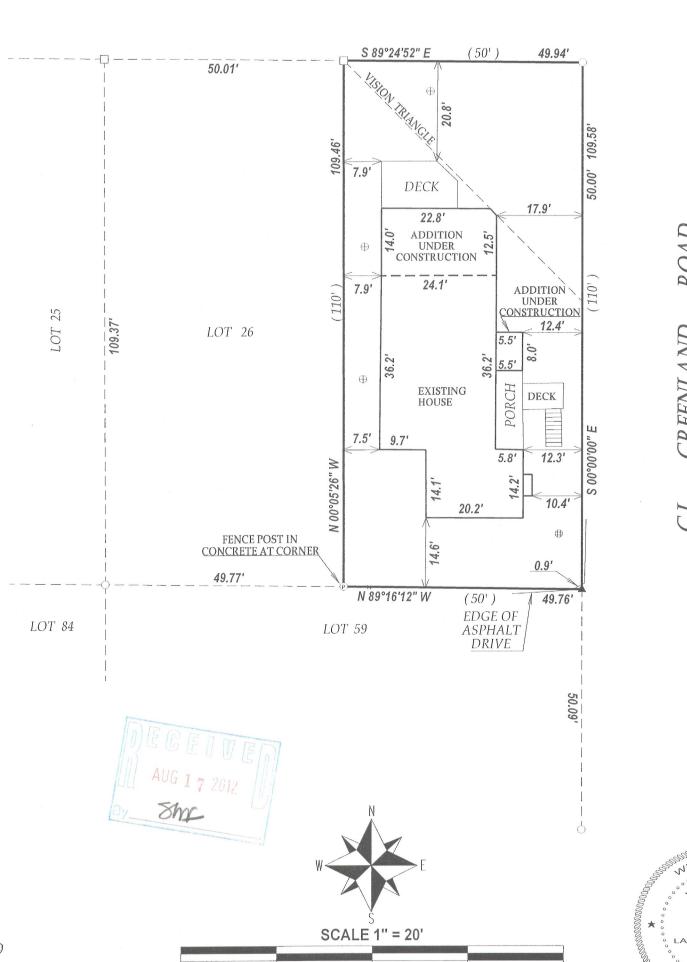

LEGEND

- O FOUND IRON PIPE
- $\Box$  FOUND IRON BAR
- ▲ SET MAG NAIL
- ⊕ CONCRETE LID
- METAL LID

(XX) RECORDED AS

TAX ID # ILGH00026

JOB # 12-015

20 40 60 80 NOTE : THE EAST LINE OF LOT 27 WAS ASSUMED TO BE NORTH-SOUTH

I have surveyed the above-described property and the above map is a true representation thereof and shows the size and location of the property, its exterior boundaries, the location and dimensions of all structures thereon, fences apparent easements and roadways and visible encroachments. if any.

This survey is made for the exclusive use of the present owners of the property, and also those who puchase, mortgage, or insure the title therto within one (1) year from date hereof; and as to them I warrant the accuracy of said survey map.



DATED THIS 29th DAY OF FEBRUARY 2012. DATE OF LAST REVISION: 07/16/2012 REVISED 5/03/2012

> JOHN KROTT S - 2258 Wisconsin Registered Land Surveyor ( original if signed in red )

117-3420