

Snake Road
(49.5' WIDE)

50' WIDE
RIGHT OF WAY

PLAT OF SURVEY

-OF-

LOT 1 CERTIFIED SURVEY MAP NO. 4353 BEING PART OF LOTS 4, 5 AND 6 OF HUTCHINSON'S SUBDIVISION AND UNPLATTED LAND LOCATED IN GOVERNMENT LOT 1 AND THE NORTHEAST 1/4 OF SECTION 3, TOWN 1 NORTH, RANGE 17 EAST, TOWN OF LINN, WALWORTH COUNTY, WISCONSIN.

LOT 1



NOTE: BEARINGS ARE REFERENCED TO THE RECORD C.S.M.


I have surveyed the above-described property and the above map is a true representation thereof and shows the size and location of the property, its exterior boundaries, the location and dimensions of all structures thereon, fences, apparent easements and roadways and visible encroachments, if any.

This survey is made for the exclusive use of the present owners of the property, and also those who purchase, mortgage, or insure the title thereto within one (1) year from date hereof; and as to them I warrant the accuracy of said survey map.

LEGEND


- FOUND IRON PIPE
- FOUND IRON BAR
- FOUND CONCRETE MONUMENT
- ∞ RECORDED AS

TAX ID # 1A435300001
JOB # 11-174AB

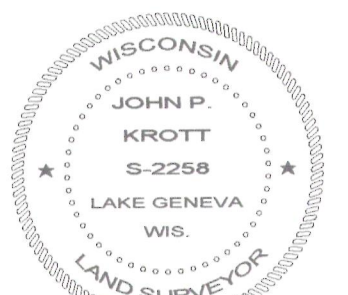

DATED THIS 21st, DAY OF DECEMBER, 2011
DATE OF LAST REVISION 10/08/2012
REVISED 06/22/12

JOHN KROTT S-2258
Wisconsin Registered Land Surveyor
(original if signed in red)

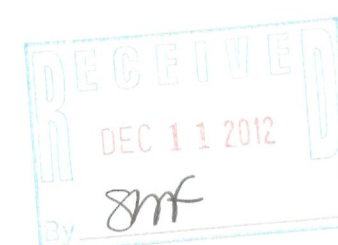

117-3478