PREPARED FOR JAY HICKS KEEFE REAL ESTATE 751 GENEVA PARKWAY LAKE GENEVA WI. 53147


PLAT OF SURVEY

-OF-

LOT 18 OF ELGIN CLUB, A SUBDIVISION LOCATED IN SECTION 4, TOWN 1 NORTH, RANGE 17 EAST, WALWORTH COUNTY, WISCONSIN.

KROTT SURVEYING INC.

N3705 WILLOW BEND LANE LAKE GENEVA WI. 53147 PHONE # (262)248-3697 FAX # (262)249-0639

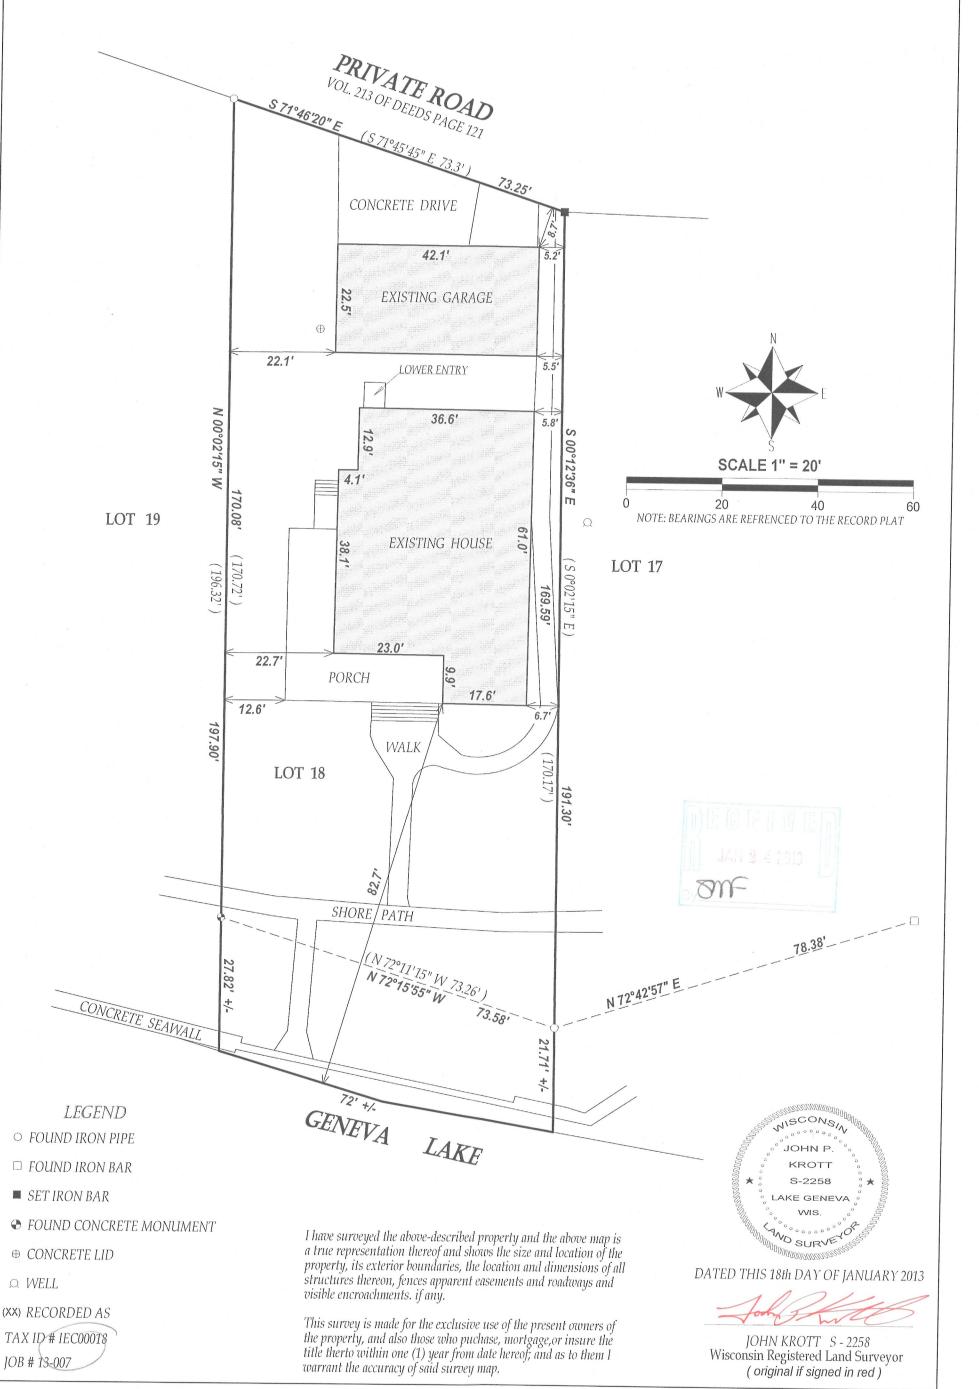

117-3498