

Plat of Survey

of

Lots 8, 9 and 10 of The Birches First Addition,

a subdivision located in Government Lot 1 in the Northeast 1/4 of Section 9, Town 1 North, Range 17 East,
Town of Linn, Walworth County, Wisconsin.


Geneva

Lake


Surveyed for: **Tim Driscoll**
5001 Tonyawatha Trail
Monona, Wisconsin. 53716

Survey Date: May 31, 2013.
Revisions:

Scale in Feet
1" = 30'
0' 15' 30' 60'

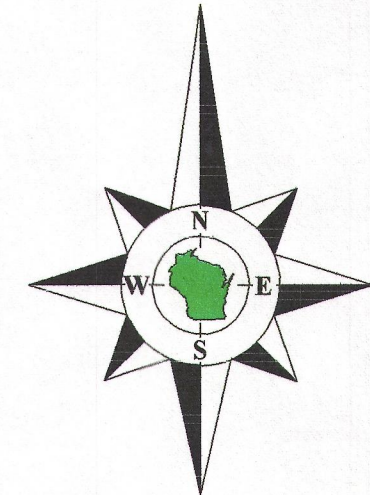

Bearings reference to the plat of
The Birches First Addition.

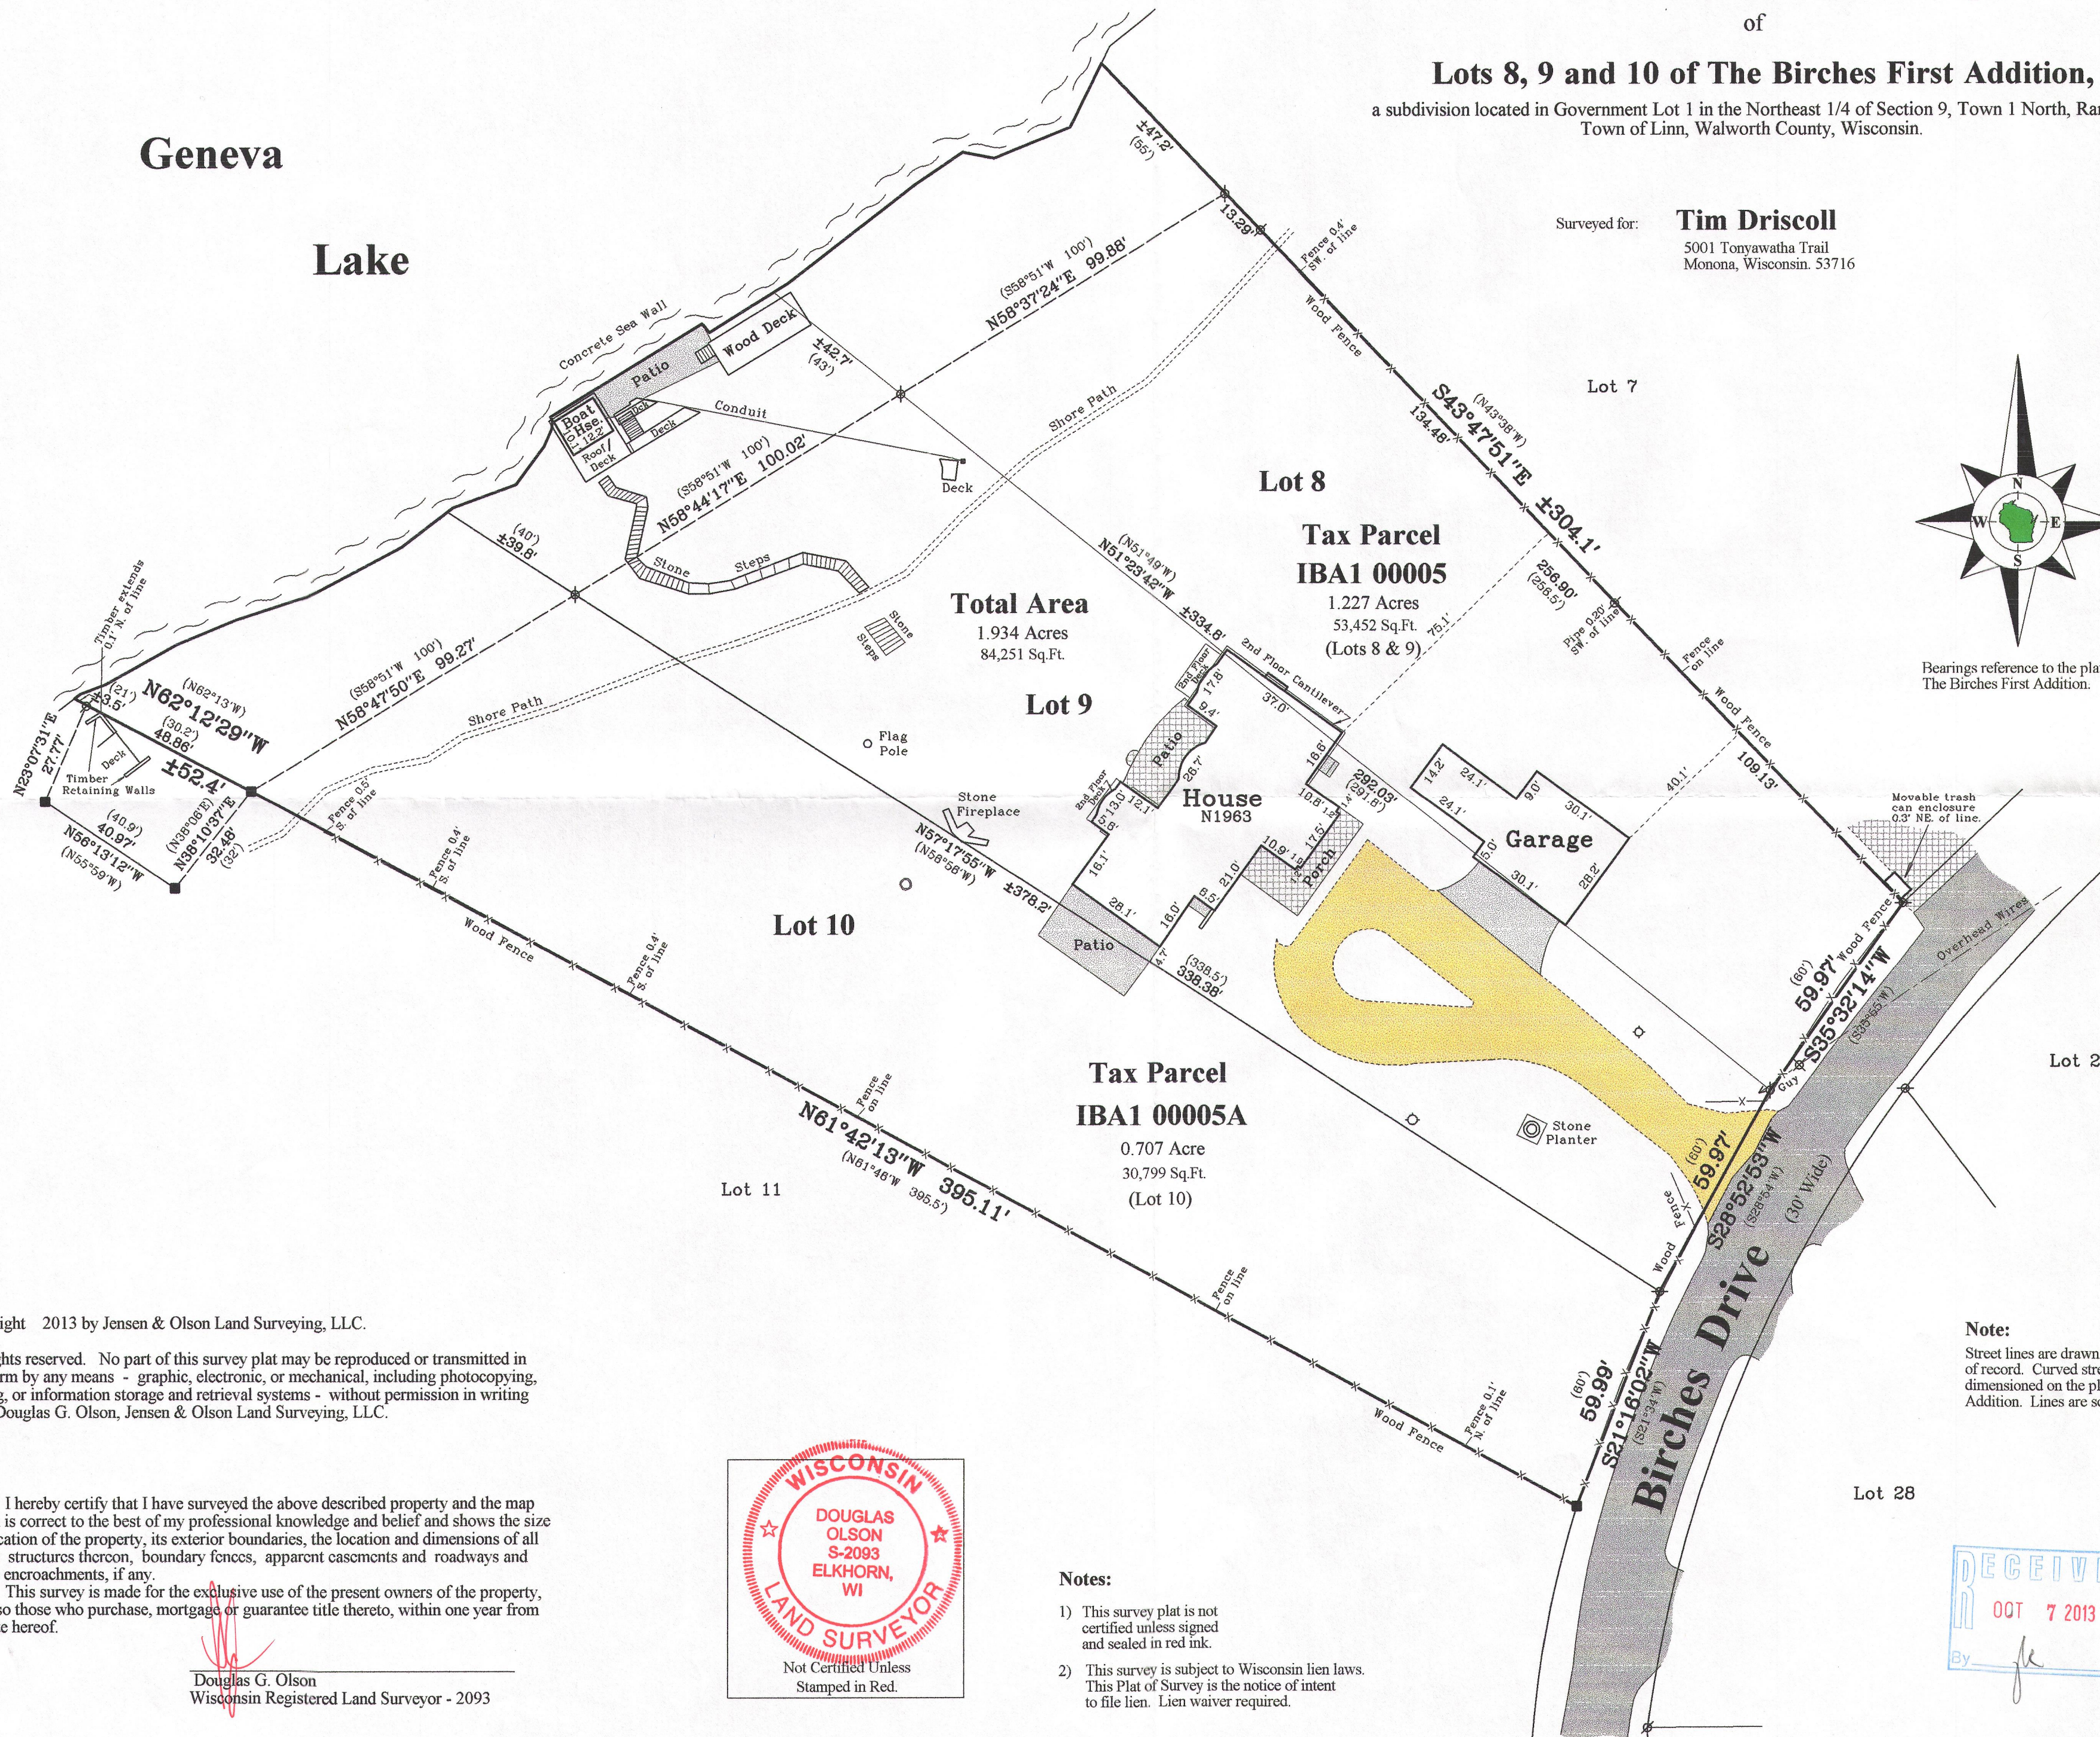


Copyright 2013 by Jensen & Olson Land Surveying, LLC.

All rights reserved. No part of this survey plat may be reproduced or transmitted in any form by any means - graphic, electronic, or mechanical, including photocopying, tracing, or information storage and retrieval systems - without permission in writing from Douglas G. Olson, Jensen & Olson Land Surveying, LLC.

I hereby certify that I have surveyed the above described property and the map hereon is correct to the best of my professional knowledge and belief and shows the size and location of the property, its exterior boundaries, the location and dimensions of all visible structures thereon, boundary fences, apparent easements and roadways and visible encroachments, if any.

This survey is made for the exclusive use of the present owners of the property, and also those who purchase, mortgage or guarantee title thereto, within one year from the date hereof.

Douglas G. Olson
Wisconsin Registered Land Surveyor - 2093

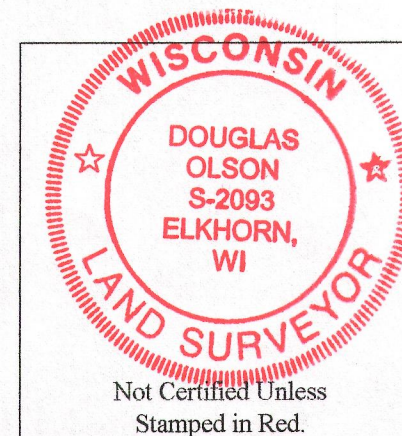


Notes:

- 1) This survey plat is not certified unless signed and sealed in red ink.
- 2) This survey is subject to Wisconsin lien laws. This Plat of Survey is the notice of intent to file lien. Lien waiver required.

Note:

Street lines are drawn as shown on a prior survey of record. Curved street lines are not adequately dimensioned on the plat of The Birches First Addition. Lines are scaled from the recorded plat.

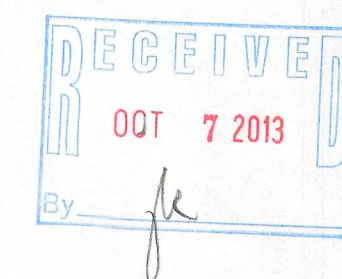

Jensen & Olson Land Surveying, LLC

45 South Wisconsin Street * P.O. Box 322 * Elkhorn, Wisconsin. 53121
Telephone: (262) 723-3434 * Facsimile: (262) 723-8044
Email: jensen.olson@elknet.net

Legend
Found Concrete Monument
Found Iron Pipe
Recorded Information
Utility Pole
Concrete Cover
Asphalt Surface
Gravel Surface
Brick Pavers
Stand Pipe
Lamp

Sheet 1 of 1 Sheets
Drawing Name:
Job Reference Number
2013.046
2013.046

IBA1 -5
IBA1 -5A

117-3561