


of

a subdivision located in the Southwest 1/4 of the Southwest 1/4 of Section 10,
Town 1 North, Range 17 East, Town of Linn, Walworth County, Wisconsin.

ALSO, a parcel of land described in an Abridgment of Judgment recorded in Vol. 593 on Page 271 as Document No. 243647, as shown below:
Beginning at the Northwest corner of Lot 1, Block 8, Genvesta Subdivision; thence East 25 feet to the centerline of the vacated roadway; thence South 158 feet along the centerline of said roadway; thence East 25 feet; thence North 158 feet along the West line of said lot to the point of beginning.

ALSO, the North 1/2 of a portion of Alley vacated by Doc. No. 874961, in Block 8 of Genevista, a subdivision located in the Southwest 1/4 of the Southwest 1/4 of Section 10, Town 1 North, Range 17 East, Town of Linn, Walworth County, Wisconsin.


Surveyed for: **Jean M. Barry Trust**
2729 North Dayton Street
Chicago, Illinois. 60614

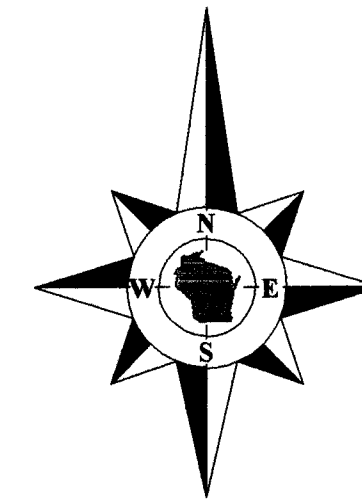

Bearings reference to previous surveys of record.


Note:

Elevations and contours shown are based upon site measurements taken prior to excavation for the new house and are no longer accurate in areas where grading has taken place.

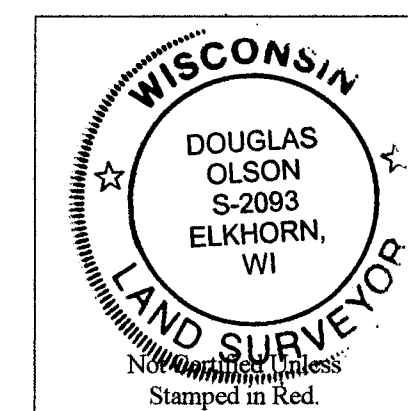

Notes:

- 1) This survey plat is not certified unless signed and sealed in red ink.
- 2) This survey is subject to Wisconsin lien laws. This Plat of Survey is the notice of intent to file lien. Lien waiver required.

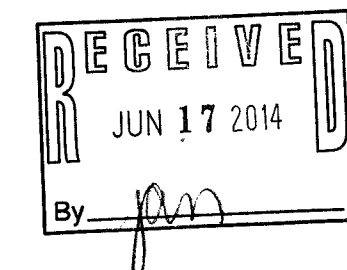

Copyright 2012 by Jensen & Olson Land Surveying, LLC.

All rights reserved. No part of this survey plat may be reproduced or transmitted in any form by any means - graphic, electronic, or mechanical, including photocopying, tracing, or information storage and retrieval systems - without permission in writing from Douglas G. Olson, Jensen & Olson Land Surveying, LLC.

I, Douglas G. Olson, Wisconsin Registered Land Surveyor, do hereby certify that this survey was performed by me, or under my direction in full compliance with the owner's/agent's instructions and Chapter A-E 7 of the Wisconsin Administrative Code "Minimum Standards for Property Surveys", and that this map is an accurate representation thereof to the best of my knowledge and belief.

Douglas G. Olson
Wisconsin Registered Land Surveyor - 2093

No. 6 - Alley Vacations
& Revised Garage
Location
No. 7 - Garage As-Built

Survey Date: July 27, 2012.

Revisions: No. 1 – Set Lath
No. 2 – Proposed House Deck & Garage
No. 3 – House Staking & Benchmark
No. 4 – Foundation
No. 5 – Prop. Garage

Scale in Feet
1" = 20'

Jensen & Olson Land Surveying, LLC

Wisconsin Street * P.O. Box 322 * Elkhorn, Wisconsin. 53121
Telephone: (262) 723-3434 * Facsimile: (262) 723-8044
Email: jensen.olson@elknet.net

Legend

- Found Iron Pipe
- Found Iron Rod
- Set Iron Pipe, 1" dia.
- Set Iron Pipe, 1 1/2" dia.
- Set Wood Stake
- Set Wood Stake
- Recorded Information
- Recorded Information
- Utility Pole
- Utility Pole
- Septic Vent
- Septic Vent
- Asphalt Surface
- Asphalt Surface
- Concrete Surface
- Concrete Surface

Sheet 1 of 1 Sheets

Drawing Name: thrl17e-2012058-2012058P

Job Reference Number

2012.058

2012.058

IGV - 40A

117-3659