PREPARED FOR TYLER MEYER SHOREWEST REALTY DELAVAN WI

PLAT OF SURVEY

- OF -

PATHFINDER SURVEYING INC.

(formerly)


J.K. SURVEYING INC.


P.O BOX 322

LAKE GENEVA, WI. 53147

WWW.PATHFINDERSURVEYING.NET
262-248-8303

LOTS 40 THRU 43 AND LOTS 53 AND 54 EDGEWATER WATER TERRACE SUBDIVISION LOCATED IN TOWN 1 NORTH, RANGE 17 EAST, WALWORTH COUNTY, WISCONSIN.

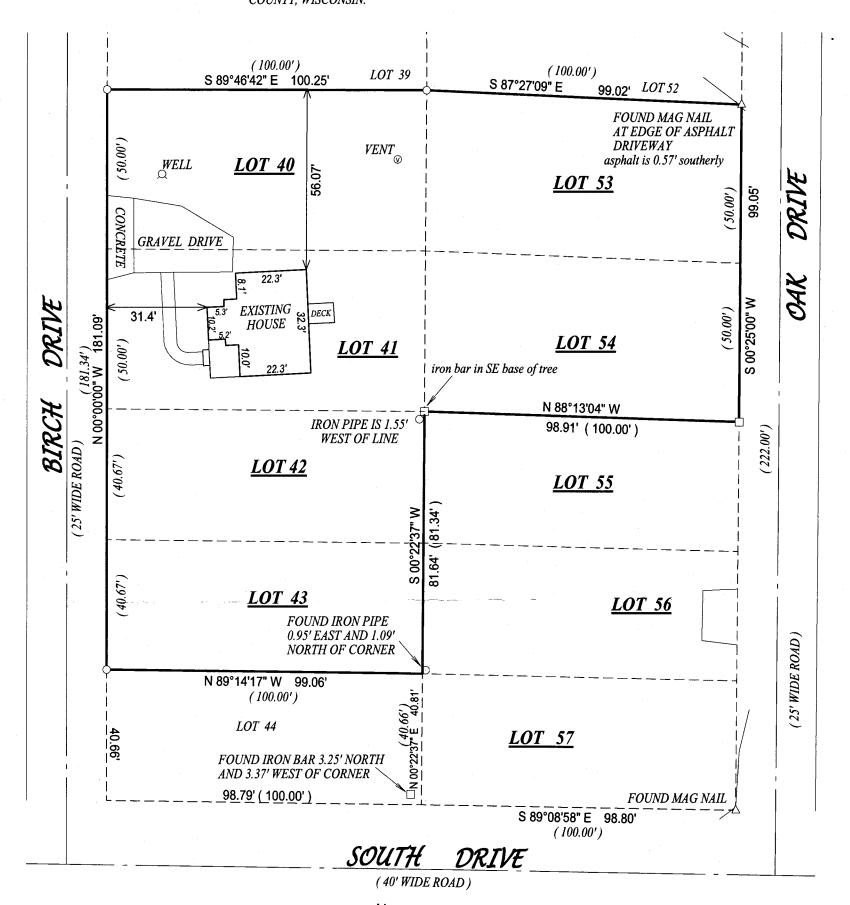

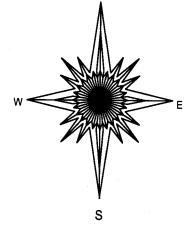

()= recorded as

 \Box = found iron bar

 \bigcirc = found iron pipe

= set iron pipe


= set iron bar

SCALE 1'' = 30'

JOB # 14-126

TAX ID # IE00036-39 & IE00050


30

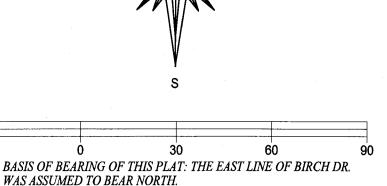

"I hereby certify that I have surveyed the above described property and that the above map, to the best of my knowledge and belief, is a true representation thereof and shows the size and location of all visible structures, apparent easements and encroachments if any."

This survey is made for the present owners of the property, and those who purchase, mortgage, or guarentee the title thereto, within one year from the date hereof.

DATED THIS 18TH DAY OF JUNE, 2014.

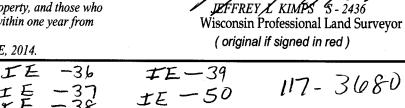

DEGETVEN