




PREPARED FOR
LAEL VANDENBURG
KEEFE REAL ESTATE
751 GENEVA PARKWAY
LAKE GENEVA, WI 53147

PATHFINDER SURVEYING INC.
(formerly)
J.K. SURVEYING INC.
P.O BOX 322
LAKE GENEVA, WI. 53147
WWW.PATHFINDERSURVEYING.NET
262-248-8303


PLAT OF SURVEY

- OF -

LOT 2 OF LAKE GENEVA BEACH SUBDIVISION, LOCATED
IN SECTION 11, TOWN 1 NORTH, RANGE 17 EAST,
TOWN OF LINN, WALWORTH COUNTY, WISCONSIN.

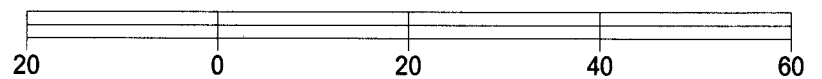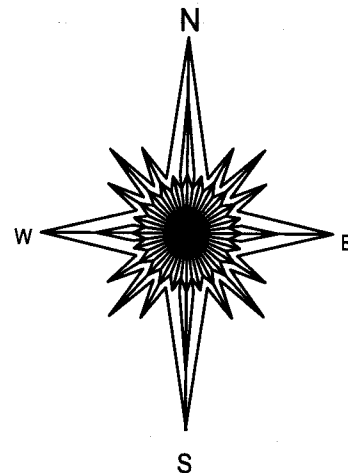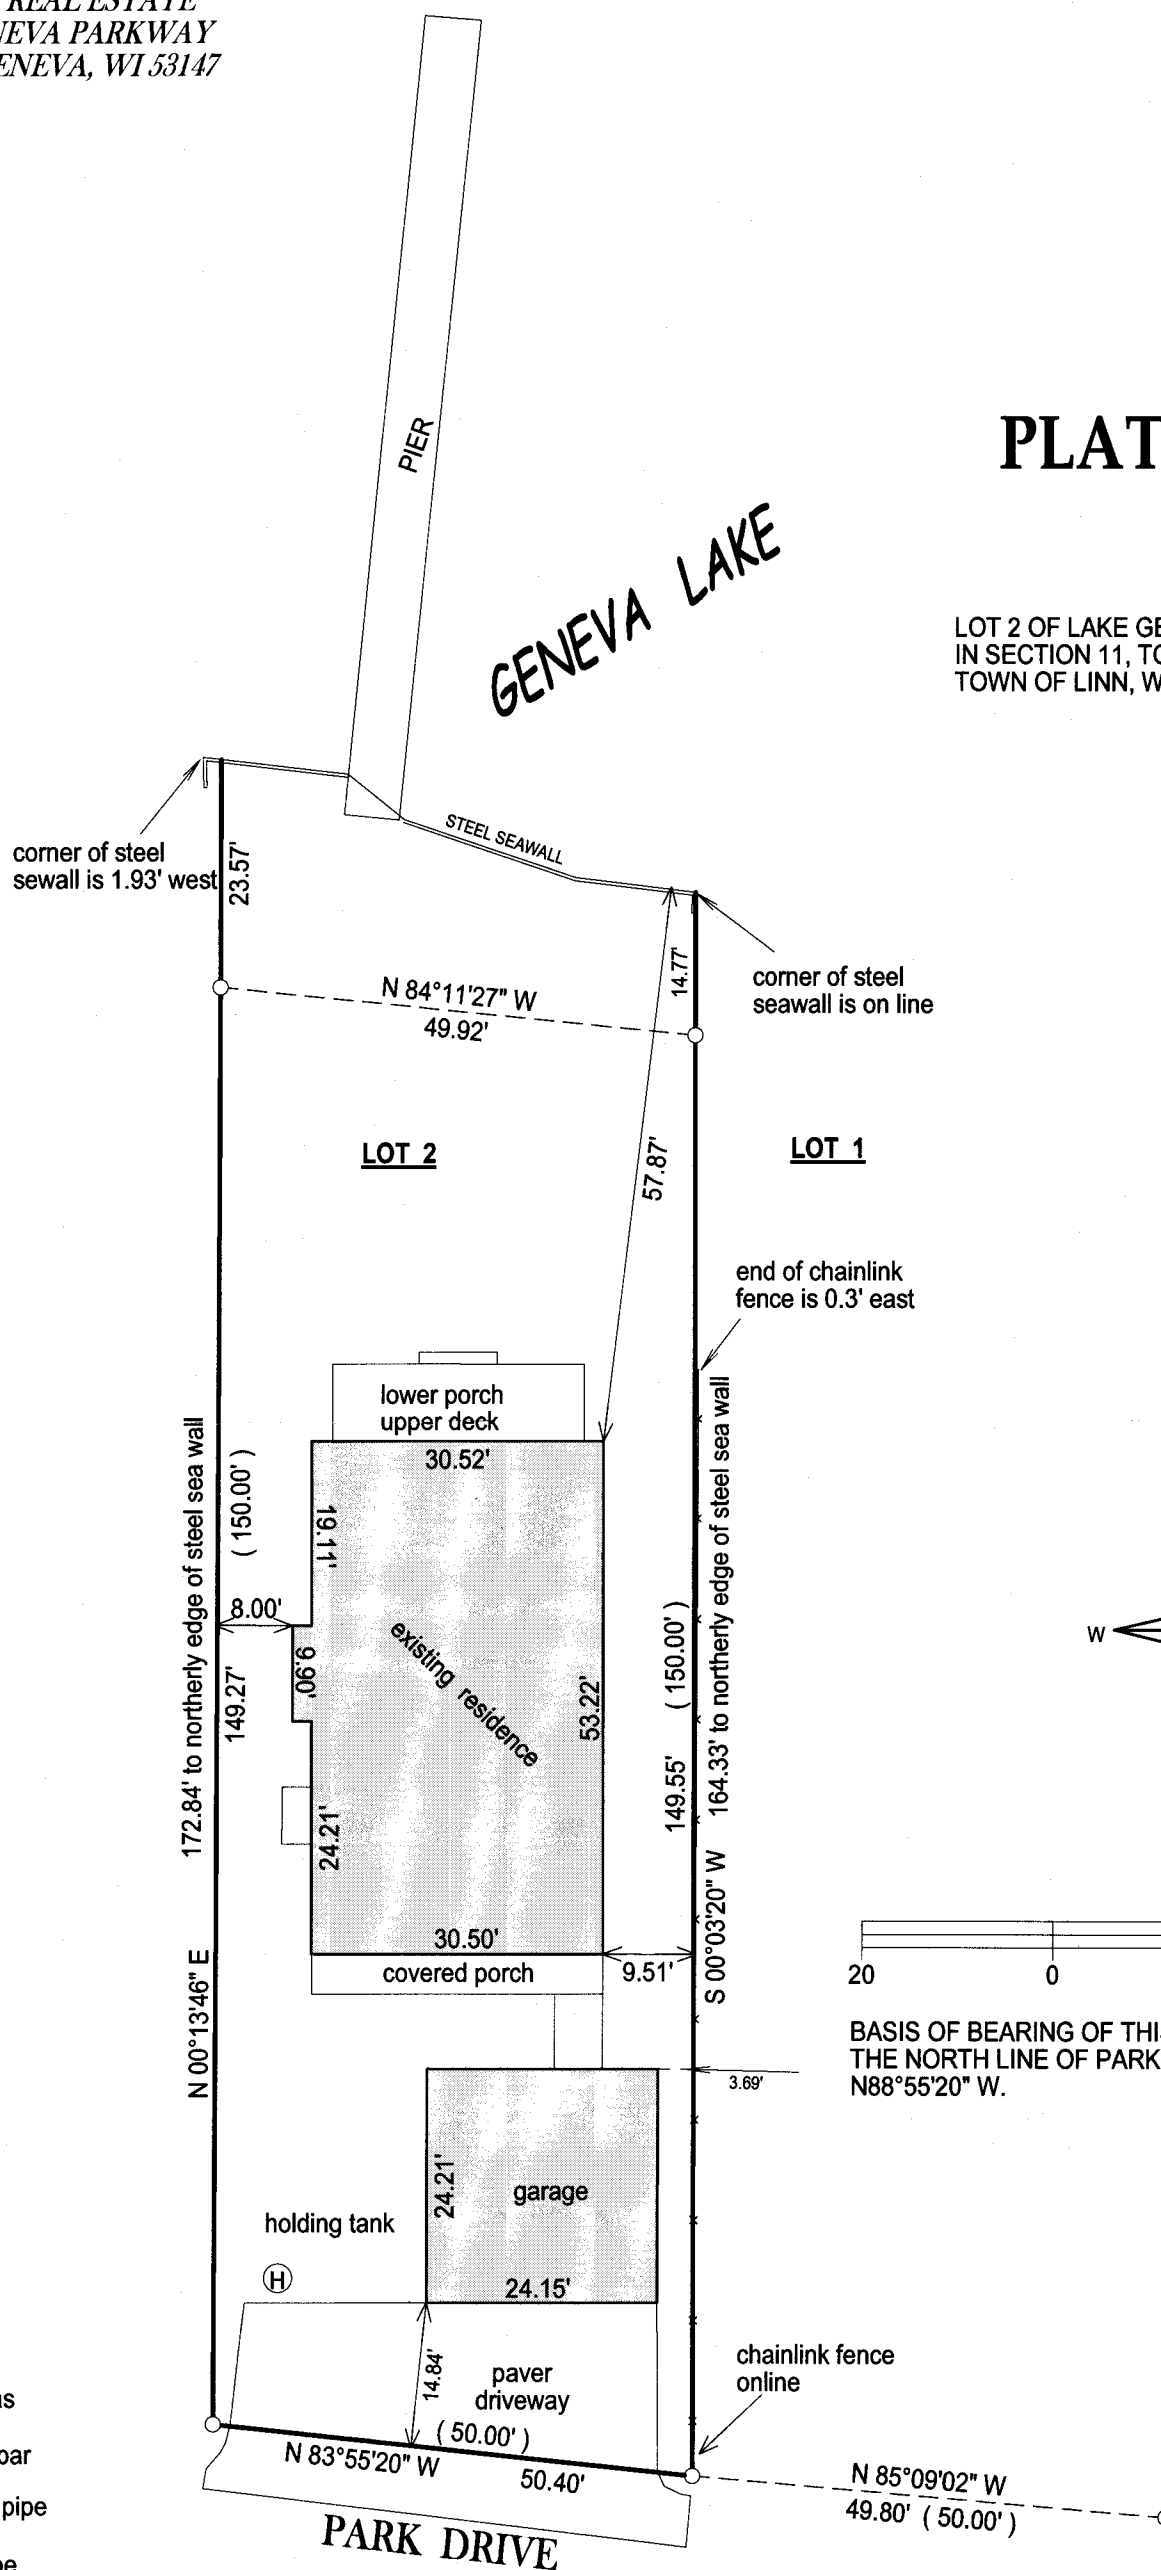

BASIS OF BEARING OF THIS PLAT: PREVIOUS SURVEYS OF RECORD.
THE NORTH LINE OF PARKM DR WAS ASSUMED TO BEAR
N88°55'20" W.

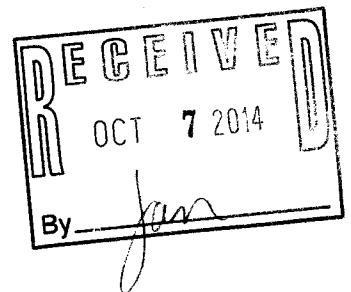

JEFFREY L. KIMPS S - 2436
Wisconsin Registered Land Surveyor
(original if signed in red)

- () = recorded as
- = found iron bar
- = found iron pipe
- = set iron pipe
- = set iron bar

SCALE 1" = 20'

JOB # 14-96

TAX ID #

ILGB00001A

I hereby certify that I have surveyed the above- described property and the above map is a true representation thereof and shows the size and location of the property, its exterior boundaries, the location and dimensions of all structures thereon, fences, apparrant easements and roadways and visible encroachments if any.

This survey is made for the present owners of the property, and those who purchase, mortgage, or guarantee the title thereto, within one year from the date hereof.

DATED THIS 27TH DAY OF MAY, 2014.

ILGB-1A

117-3682