
HAROLD IL KOLS

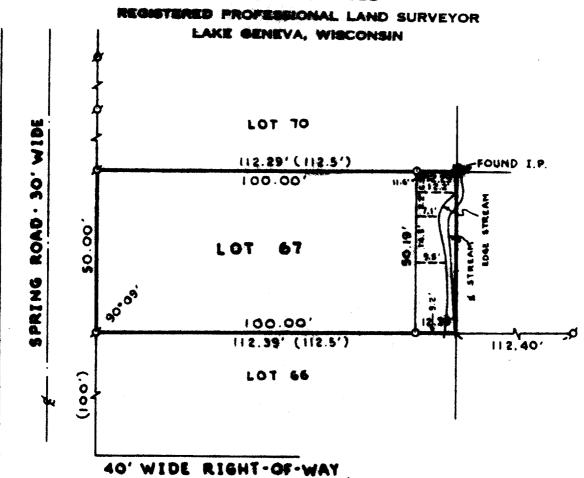

PLAT OF SURVEY OF

SCALE: 1"+30"

Lor 67, Take Geneva Reach Subditionation, T.1 N. R. 17 E. Walworth County. Wisconsin.

## LEGENO

. - IRON PIPE FOUND

O - INON PIPE PLACED

. - CONCRETE MONUMENT

X - SPIKE

O-As platted



I. HAROLD H. KOLB, DO HERESY CERTIFY THAT I HAVE SURVEYED THE PROPERTY HEREON DESCRIBED ACCORDING TO THE OFFICIAL RECORDS. AND THAT THE PLAT HEREON IS A CORRECT REPRESENTATION OF THE LOT LINES.

Harreld H. Kolk

HARGLD H. KOLB

WISCONSIN REGISTERED LAND SURVEYOR, S-187

DATE March 7, 1973

IL6B-59

117-369