PREPARED FOR SCOTT ECKBURG 1728 NATIONAL AVE. ROCKFORD IL 61103

OF SURVEY PLAT

LOT 66 IN ROBINSON'S SECOND SUBDIVISION OF A PART OF SECTIONS 11 AND 14, TOWN 1 NORTH, RANGE 17 EAST, BEING IN THE TOWN OF LINN ACCORDING TO THE PLAT OF ROBINSON'S 2nd SUBDIVISION OF RECORD IN THE OFFICE OF THE REGISTER OF DEEDS FOR WALWORTH COUNTY, WISCONSIN.

LYNCH & ASSOCIATES ENGINEERING CONSULTANTS, LLC.

5482 S. WESTRIDGE DR. NEW BERLIN, WI 53151 (262) 248-3697

STREET MAPLE (40'WIDE)

LEGEND

O FOUND IRON 1" PIPE

☐ FOUND 5/8" IRON BAR

Q WELL


Ø UTILITY POLE

---- WOOD FENCE

(XX) RECORDED AS

M MANHOLE

TAX ID # IRB200050 IOB # 14-566

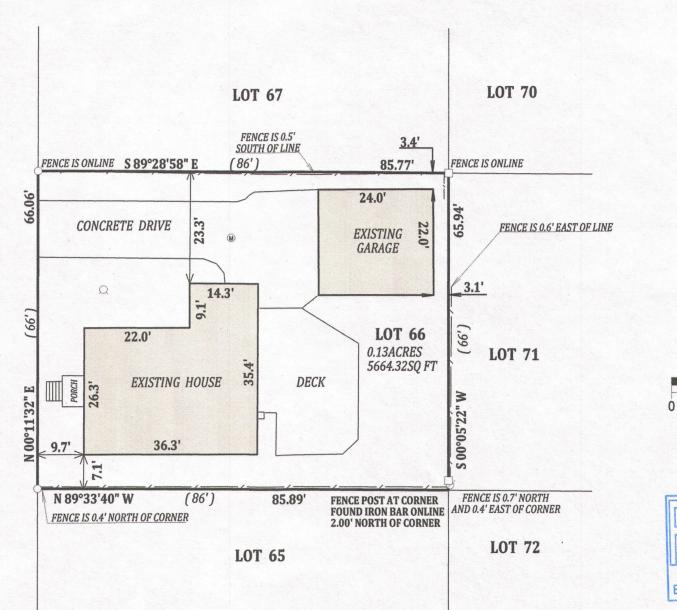

1. This survey is a retracement of that performed by John Krott

2. No title commitment or reults of a title search were provided to this office pertaining to this survey. This Plat Of Survey may not reflect easements of record, encumbrances, restrictions,

ownership, title evidence, or other facts that a current and

accurate title search may disclose.

I have surveyed the above-described property and the above map is a true representation thereof and shows the size and location of the property, its exterior boundaries, the location and dimensions of all structures thereon, fences apparent easements and roadways and visible encroachments. if any.

This survey is made for the exclusive use of the present owners of the property, and also those who puchase, mortgage,or insure the title therto within one (1) year from date hereof; and as to them I warrant the accuracy of said survey map.



DATED THIS 2nd DAY OF OCTOBER 2013 LAST REVISED THIS 21st DAY OF JUNE, 2014

KENNETH B. MEHRING S - 2838 Wisconsin Registered Land Surveyor (original if signed in red)

SCALE 1" = 20'

20

NOTE: BEARINGS ARE REFRENCED TO THE RECORD PLAT.