PREPARED FOR: MARGARET LABUS D'APRILE PROPERTIES

PLAT OF SURVEY

-OF-

LYNCH & ASSOCIATES ENGINEERING CONSULTANTS, LLC. 5482 S. WESTRIDGE DR.


5482 S. WESTRIDGE DR. NEW BERLIN, WI 53151 (262) 248-3697

LOT 34 OF ADDITION "F" TO COUNTRY CLUB ESTATES, AS DULY RECORDED IN WALWORTH COUNTY RECORDS AND LOCATED IN THE SOUTHEAST 1/4 OF SECTION 14, TOWNSHIP 1 NORTH, RANGE 16 EAST, VILLAGE OF FONTANA-ON-GENEVA-LAKE, WALWORTH COUNTY, WISCONSIN.

LOT 30

LOT 29

COUNTRY CLUB ESTATES, ADDITION "D"

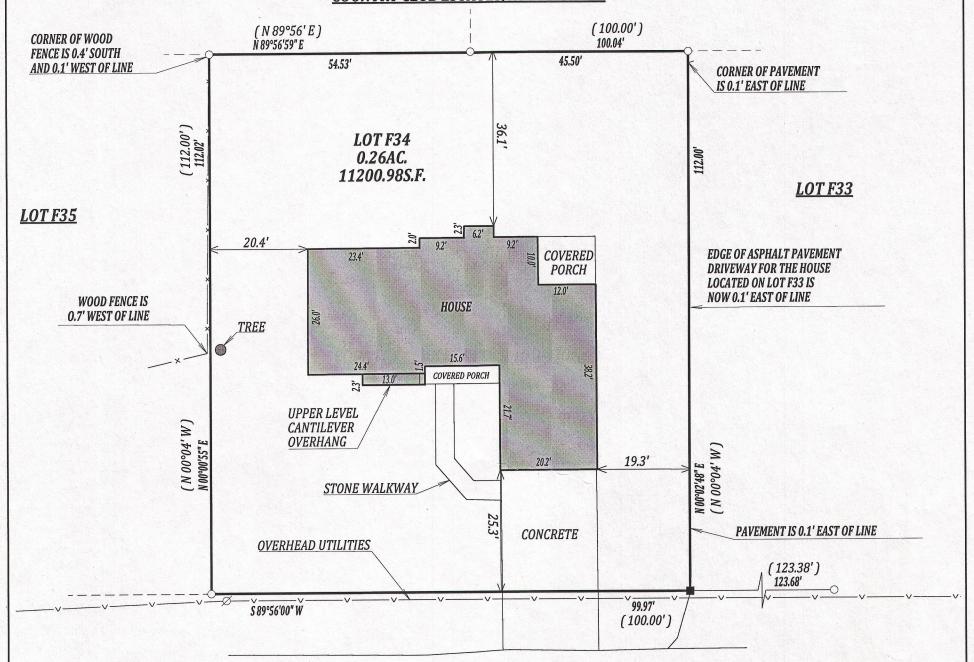


C/L FOREST DRIVE

(50' WIDE)

LEGEND

- O FOUND 1" IRON PIPE
- SET 1.3" O.D. IRON PIPE, 1.13#/L.F.
- (XX) RECORDED AS
- Ø POWER POLE

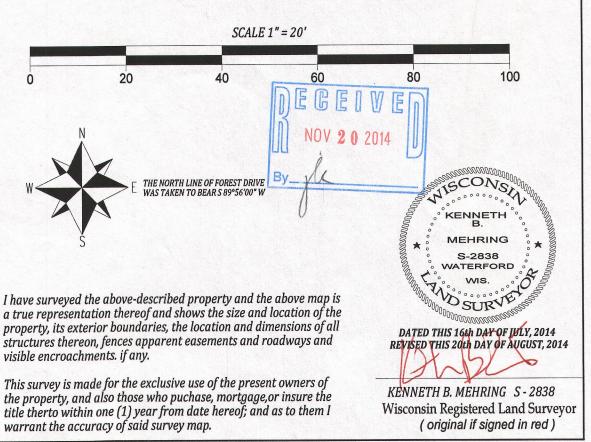

JOB # 14-583 UD TAX ID # SCTF00034