
## PLAT OF SURVEY

November 16, 2016

LOCATION: W4160 Lakeview Road, Wisconsin PREPARED FOR: Geneva Lakefront Realty

**LEGAL DESCRIPTION:** 

Lot 13 in the plat of Lake Geneva Highlands Subdivision, being a part of the Southeast 1/4 of Section 8, T1N, R17E, Town of Linn, County of Walworth, State of Wisconsin.

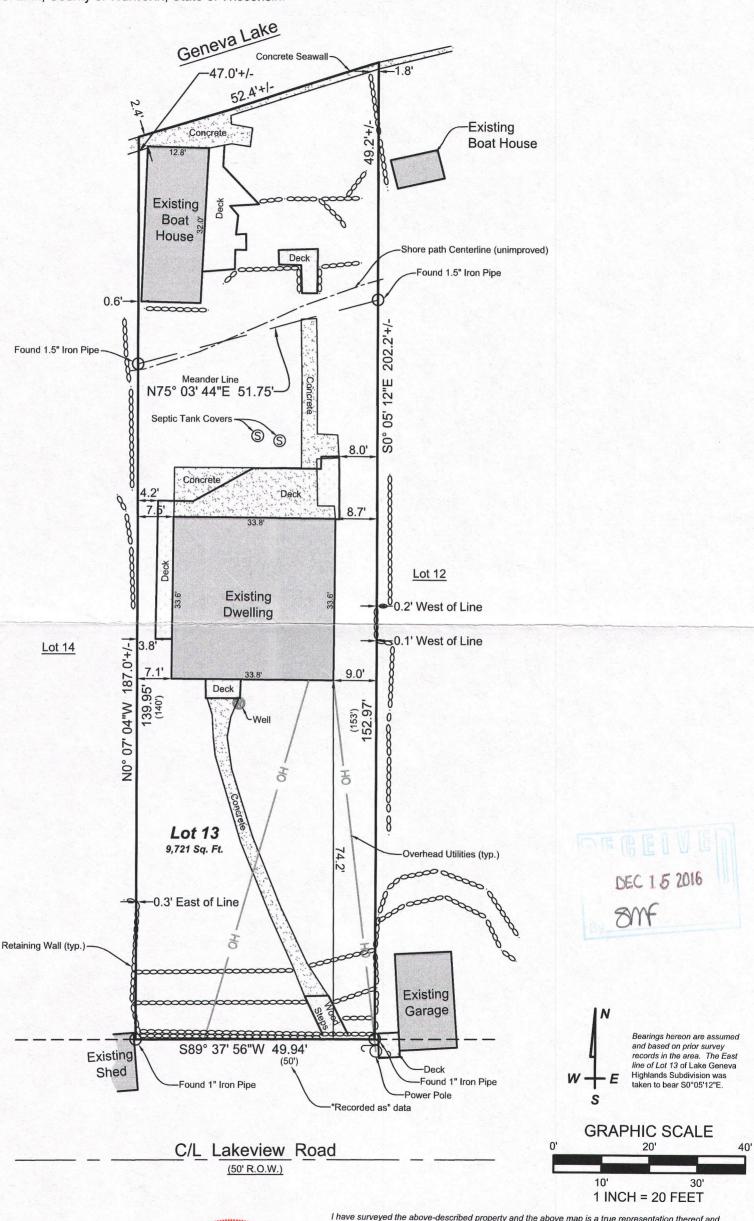



LYNCH & ASSOCIATES ENGINEERING CONSULTANTS, LLC

5482 S. WESTRIDGE DRIVE NEW BERLIN, WI 53151

SURVEYOR'S OFFICE: 432 MILWAUKEE AVE. BURLINGTON, WI 53105 (262) 248-3697 DRAWING BY: KBM
FIELD WORK BY: LMG

I have surveyed the above-described property and the above map is a true representation thereof and shows the size and location of the property, its exterior boundaries, the location and dimensions of all structures thereon, fences, apparent easements and roadways, and visible encroachments, if any.

No title commitment or results of a title search were provided to this office pertaining to this survey. This Plat Of Survey may not reflect easements of record, encumbrances, restrictions, ownership, title evidence, or other facts that a current and accurate title search may disclose.

This survey is made for the exclusive use of the present owners of the property, and also those who purchase, mortgage, or insure the title thereto within one (1) year from date hereof; and as to them I warrant the accuracy of said survey map.



1104-10

117-3964