
PREPARED FOR MARY BRENNAN @ PROPERTIES LAKE GENEVA, WI.

 
PLAT OF SURVEY

- OF -

PATHFINDER SURVEYING INC. (formerly) J.K. SURVEYING INC. P.O BOX 322 LAKE GENEVA, WI. 53147 WWW.PATHFINDERSURVEYING.NET 262-248-8303

LOTS 24 AND 25, BLOCK 3 OF WOODDALE ADDITION, BEING A SUBDIVISION LOCATED IN SECTIONS 9 AND 16, TOWN 1 NORTH, RANGE 17 EAST, TOWN OF LINN, COUNTY OF WALWORTH AND STATE OF WISCONSIN.

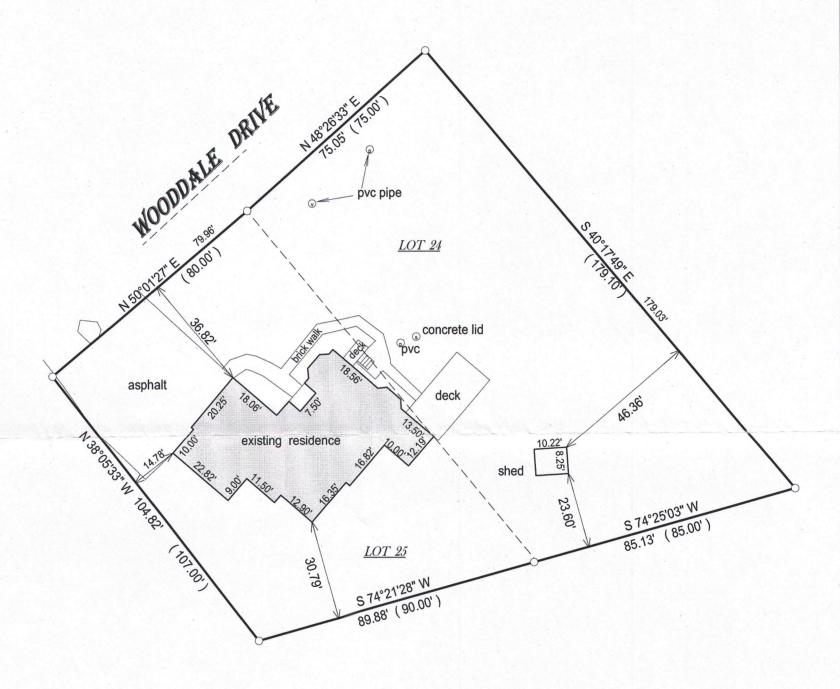




- = found iron bar
- = found iron pipe
- = set iron pipe
- = set iron bar

SCALE 1" = 30'

JOB # 16-278

TAX ID # IW00038

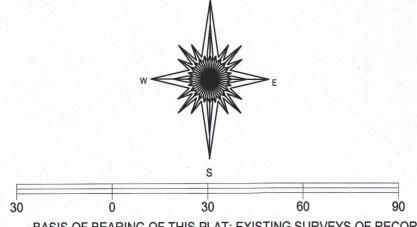

BASIS OF BEARING OF THIS PLAT: EXISTING SURVEYS OF RECORD.

I hereby certify that I have surveyed the above- described property and the above map is a is a true representation thereof and shows the size and location of the property, its exterior boundaries, the location and dimensions of all structures thereon, fences, apparant easements and roadways and visible encroachments if any.

This survey is made for the present owners of the property, and those who purchase, mortgage, or guarantee the title thereto, within one year from

DATED THIS 9TH DAY OF SEPTEMBER, 2016.





JEFFREY L KIMPS S-2436 Wisconsin Professional Land Surveyor (original if signed in red)