## FARRIS, HANSEN & ASSOCIATES, INC.


ENGINEERING - ARCHITECTURE - SURVEYING 7 RIDGWAY COURT - P.O. BOX 437 - ELKHORN, WISCONSIN 53121 PHONE: (262) 723-2098 FAX: (262) 723-5886

## PLAT OF SURVEY

LOT 135 OF LAKE GENEVA BEACH, A SUBDIVISION LOCATED IN THE SW 1/4 OF THE SW 1/4 OF SECTION 11, TOWN 1 NORTH, RANGE 17 EAST, WALWORTH COUNTY, WISCONSIN

- WORK ORDERED BY -KARSTETTER CONSTRUCTION 220 N. 5th STREET DELAVAN, WI 53115



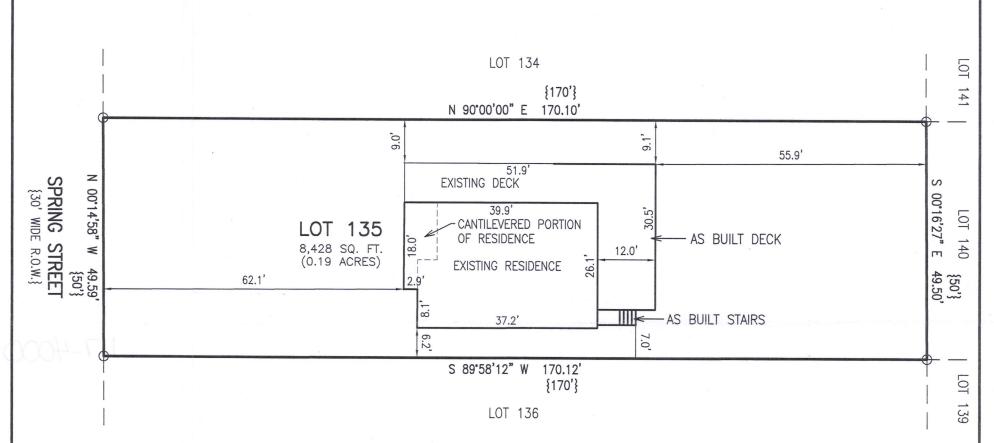



**LEGEND** 

O = FOUND IRON PIPE STAKE

 $\{XXX\} = RECORDED AS$ 

PETER S.

GORDON

ELKHORN,

W

NOTE: COPIES OF THIS MAP TO WHICH THE FOLLOWING CERTIFICATE WILL APPLY SHOW THE SURVEYOR'S ORIGINAL SEAL AND SIGNATURE IN RED INK. COPIES BY ANY OTHER MEANS MAY HAVE ALTERATIONS WHICH DO NOT REPRESENT THE SURVEYOR'S WORK PRODUCT.

I HEREBY CERTIFY THAT THE ABOVE DESCRIBED PROPERTY HAS BEEN SURVEYED UNDER MY DIRECTION AND THAT THE ABOVE MAP IS A TRUE REPRESENTATION THEREOF AND SHOWS THE SIZE AND LOCATION OF THE PROPERTY AND ITS EXTERIOR BOUNDARIES. THIS SURVEY IS MADE FOR THE USE OF THE PRESENT OWNERS OF THE PROPERTY, AND ALSO THOSE WHO PURCHASE, MORTGAGE, OR GUARANTEE THE TITLE THERETO WITHIN ONE YEAR FROM THE DATE HEREOF.

10/26/2016

Revised 2/20/17 TO SHOW AS (50) 27 GTANES + Deek EXTENSION



PETER S. GORDON P.L.S. 2101

FEB 20 2017

Survey

\PROJECTS\9633\ACAD\9633

DATED:

PROJECT: 9633 DATE: 10/26/2016 SHEET 1 OF 1