


DUNHAM & RASMUSSEN
 SURVEYING & ENGINEERING
 DELAVAN, WISCONSIN

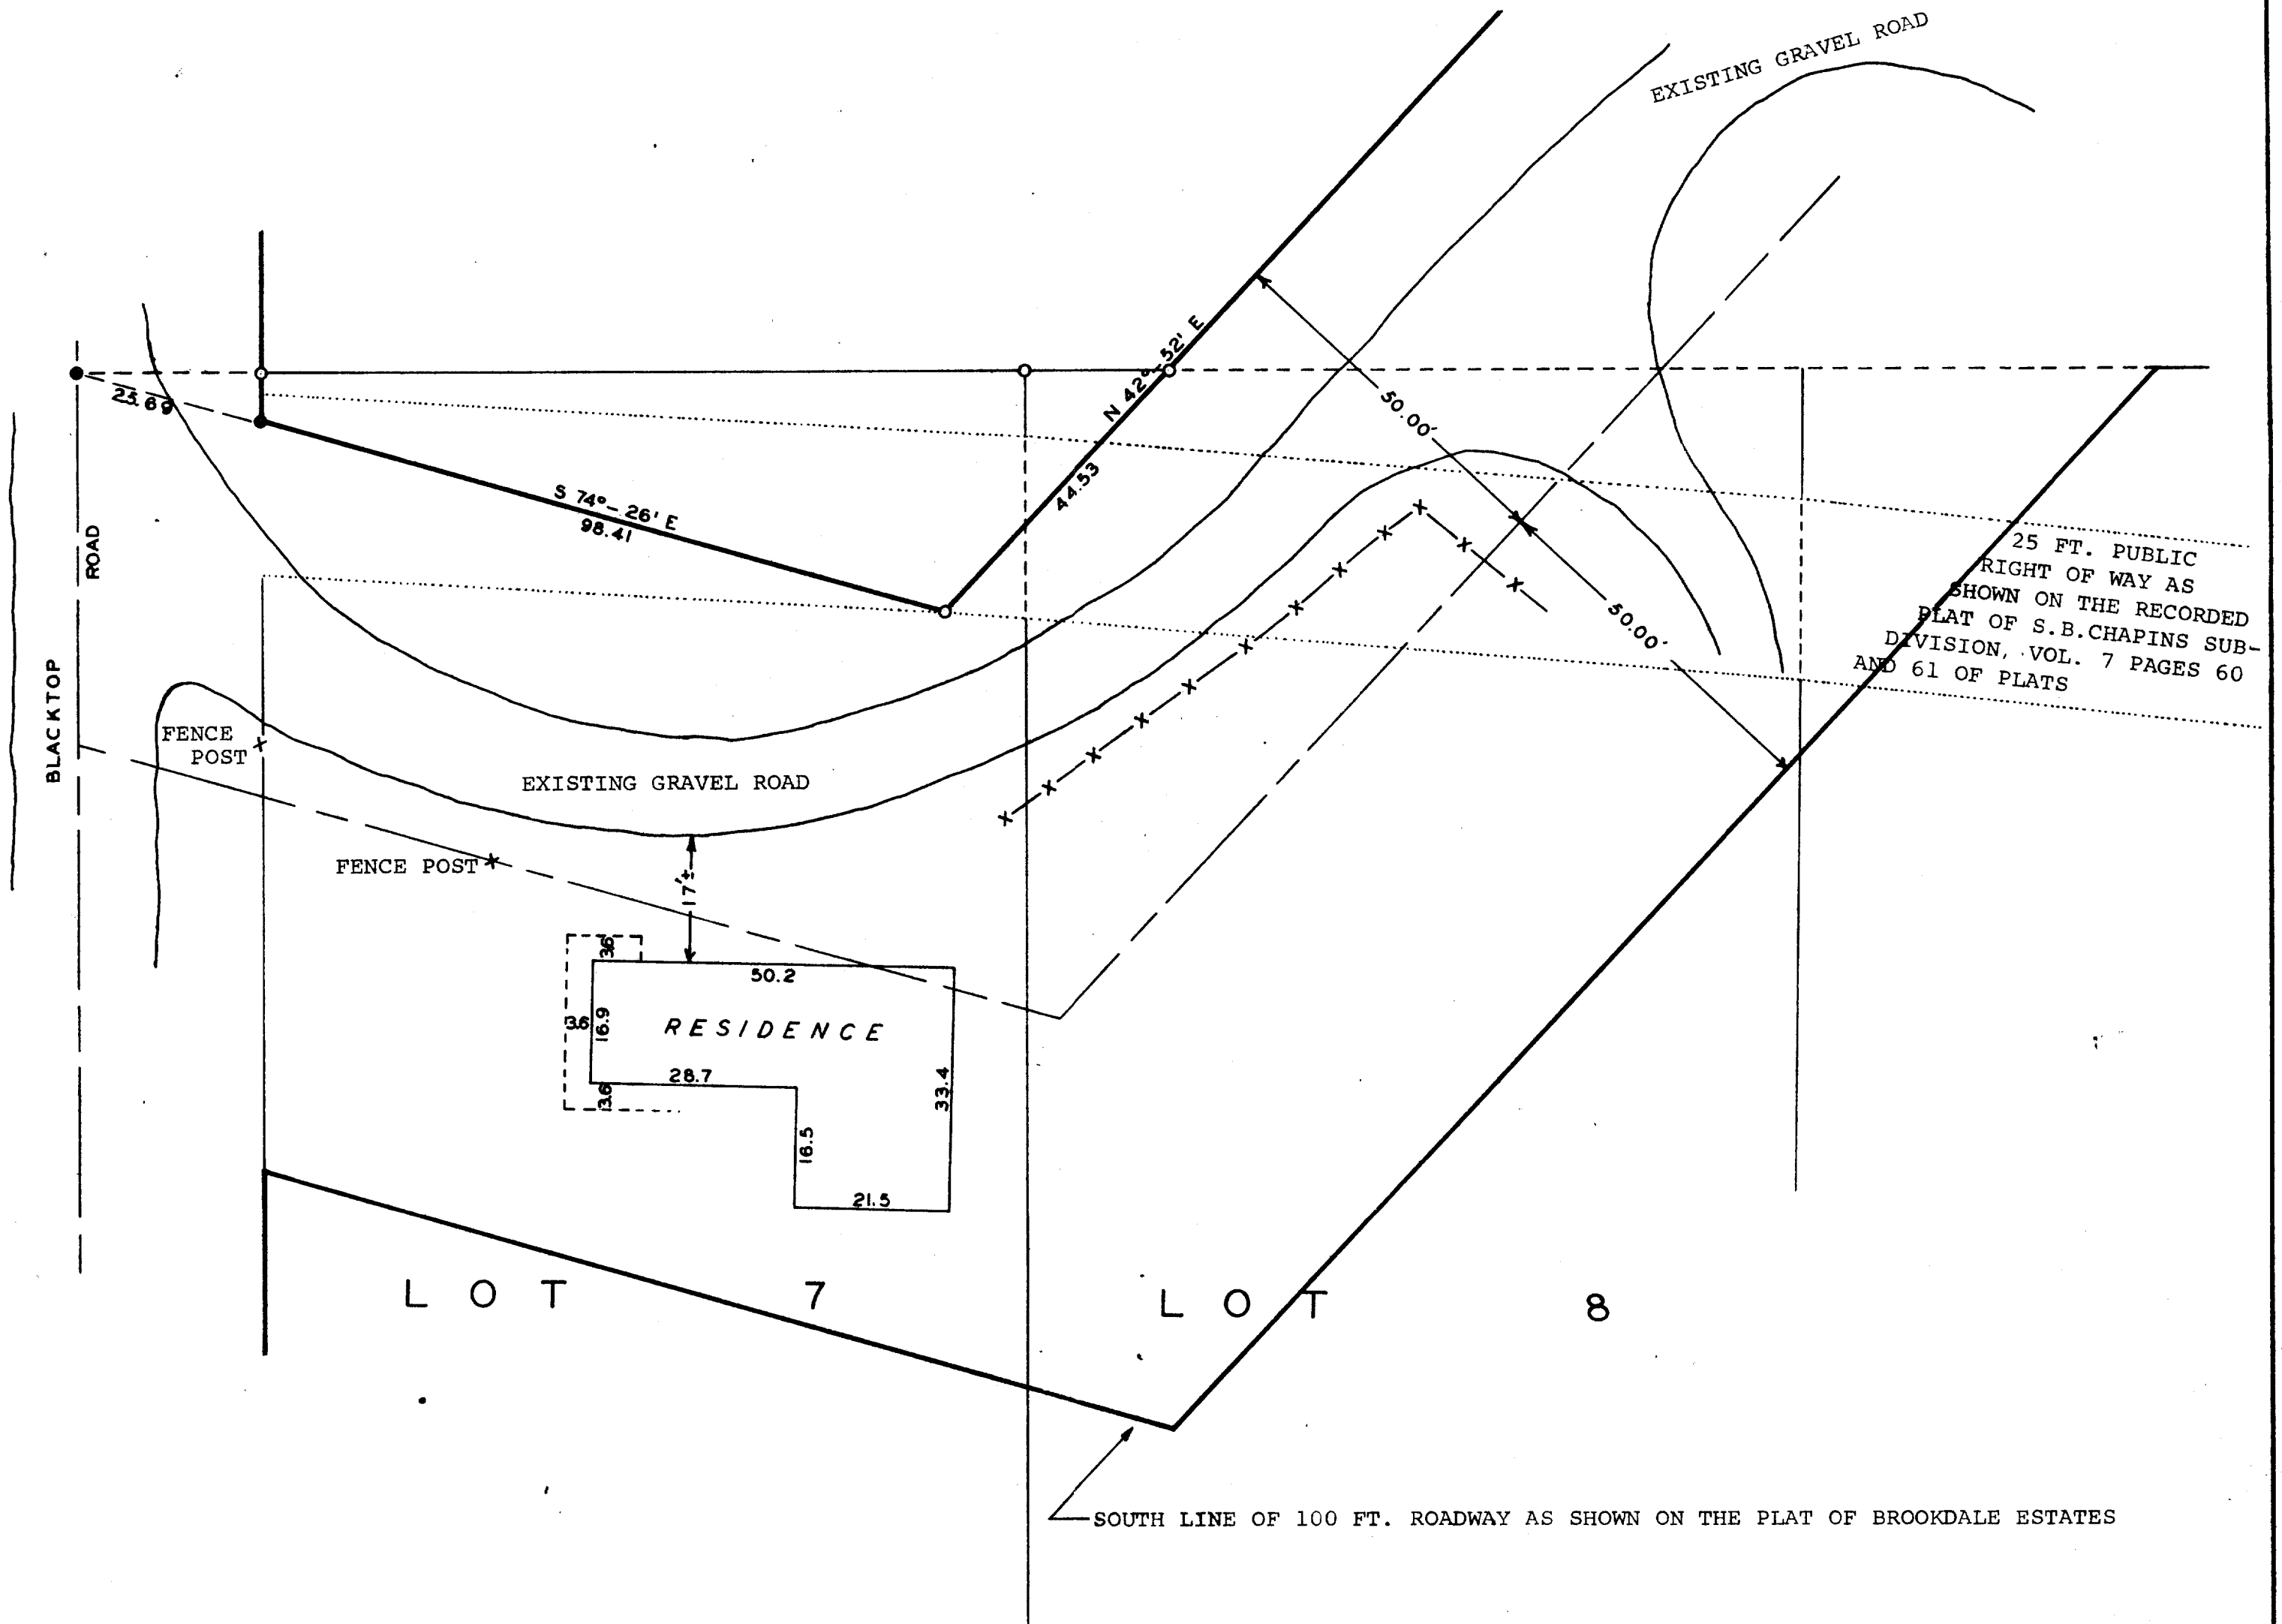

Plat showing the (roads existing and of record along the northerly portion of Lots 7, 8, & 9 of S. B. Chapins Subdivision) and adjacent land located in Section 4, T 1 N R 17 E of Walworth County, Wisconsin August 22, 1961

George T. Dunham
 George T. Dunham, Surveyor



SCALE ~ 1" = 20'
 O = IRON PIPE
 ● = CONC. MONUMENT
 -X- = FENCE
 X = FENCE POST