
HAROLD H. KOLB

REGISTERED PROFESSIONAL LAND SURVEYOR LAKE GENEVA, WISCONSIN



N

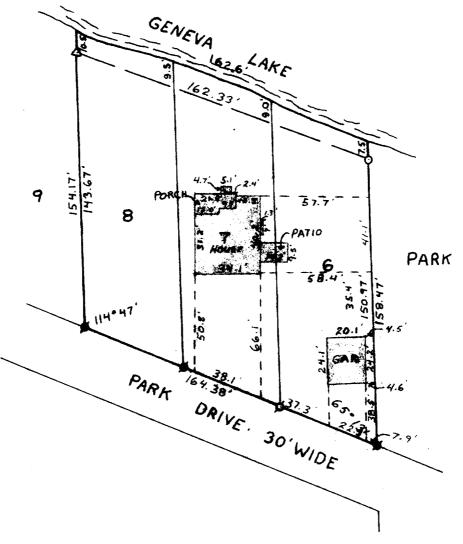

SCALE - 1"= 50"

PLAT OF SURVEY OF

lots 6,7 and 8, Lake Geneva Beach Subdivision, TIN, RITE, Welworts Counts, Wisconsin.

LECEND

6 - IRON PIPE FOUND

O - IRON FIPE PLACED

• - CONCRETE MONUMENT Found

X - SPIKE

△ - FOUND IRON ROD



I. HAROLD H. KOLB, DO HEREBY CERTIFY THAT I HAVE SURVEYED THE PROPERTY HEREON DESCRIBED ACCORDING TO THE OFFICIAL RECORDS. AND THAT THE PLAT HEREON IS A CORRECT REPRESENTATION OF THE LOT LINES, and the principal lines of the buildings thereos.

HAROLD H. KOLB

WISCONSIN REGISTERED LAND SURVEYOR, S-187

DATE October 17, 1973

REVISED: November 21, 1973

117-412

BRUNING 40-105 1M-6-71