


PLAT OF SURVEY
OF


EMAIL: ambit@tds.net

PARCEL IDENTIFICATION NO: ISA 00022

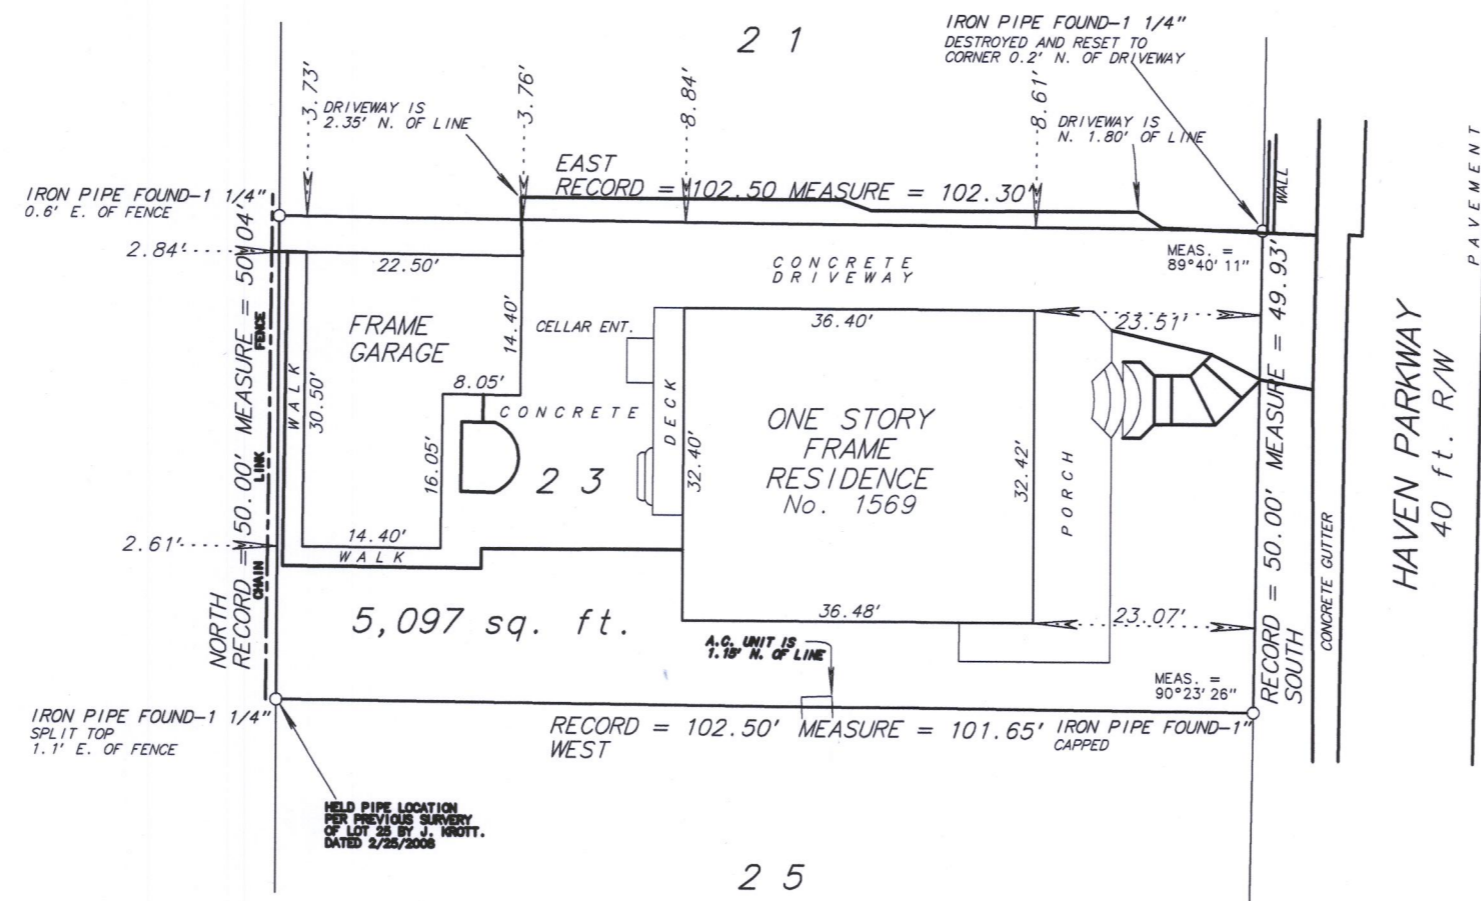

JOB NO. : 1 7 0 7 1

15A-22

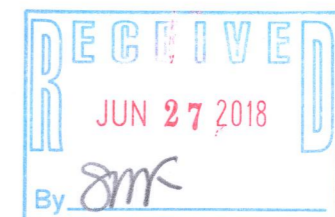

Dated at Bassett, Wisconsin this _____ day of _____ 2017.

Mark A. Bolender
Wisconsin Professional Land Surveyor - 1784

117-4141