

AMBIT LAND SURVEYING
8120-312th Avenue
Wheatland, WI. 53105-8934
Licensed Professionals in
both Illinois & Wisconsin

PLAT OF SURVEY OF

PHONE: 262-537-4874

FAX: 262-537-4221

EMAIL: ambit@tds.net


Lot 20 in LAKE GENEVA HIGHLANDS, a subdivision by Taylor and Powers of the East Third (excepting the east 100 feet thereof) of the North Half of the Southeast Full Quarter of Section 8, Township 1 North, Range 17 East of the 4th Principal Meridian, being in the Town of Linn, Walworth County, Wisconsin.

PARCEL IDENTIFICATION NO. 1LGH 00019

PROJECT BENCHMARK:
WITNESS CORNER FOR THE EAST QUARTER CORNER
OF SECTION 8-T1N-R17E. CONTROL STATION 44-3
ELEVATION = 875.855 ft. NGVD 1927

CONTOUR INTERVAL IS 0.5 ft.

SITE BENCHMARK:
BENCHMARK IN SOUTH SIDE OF
UTILITY POLE.
ELEVATION = 913.27 ft. NGVD 1927

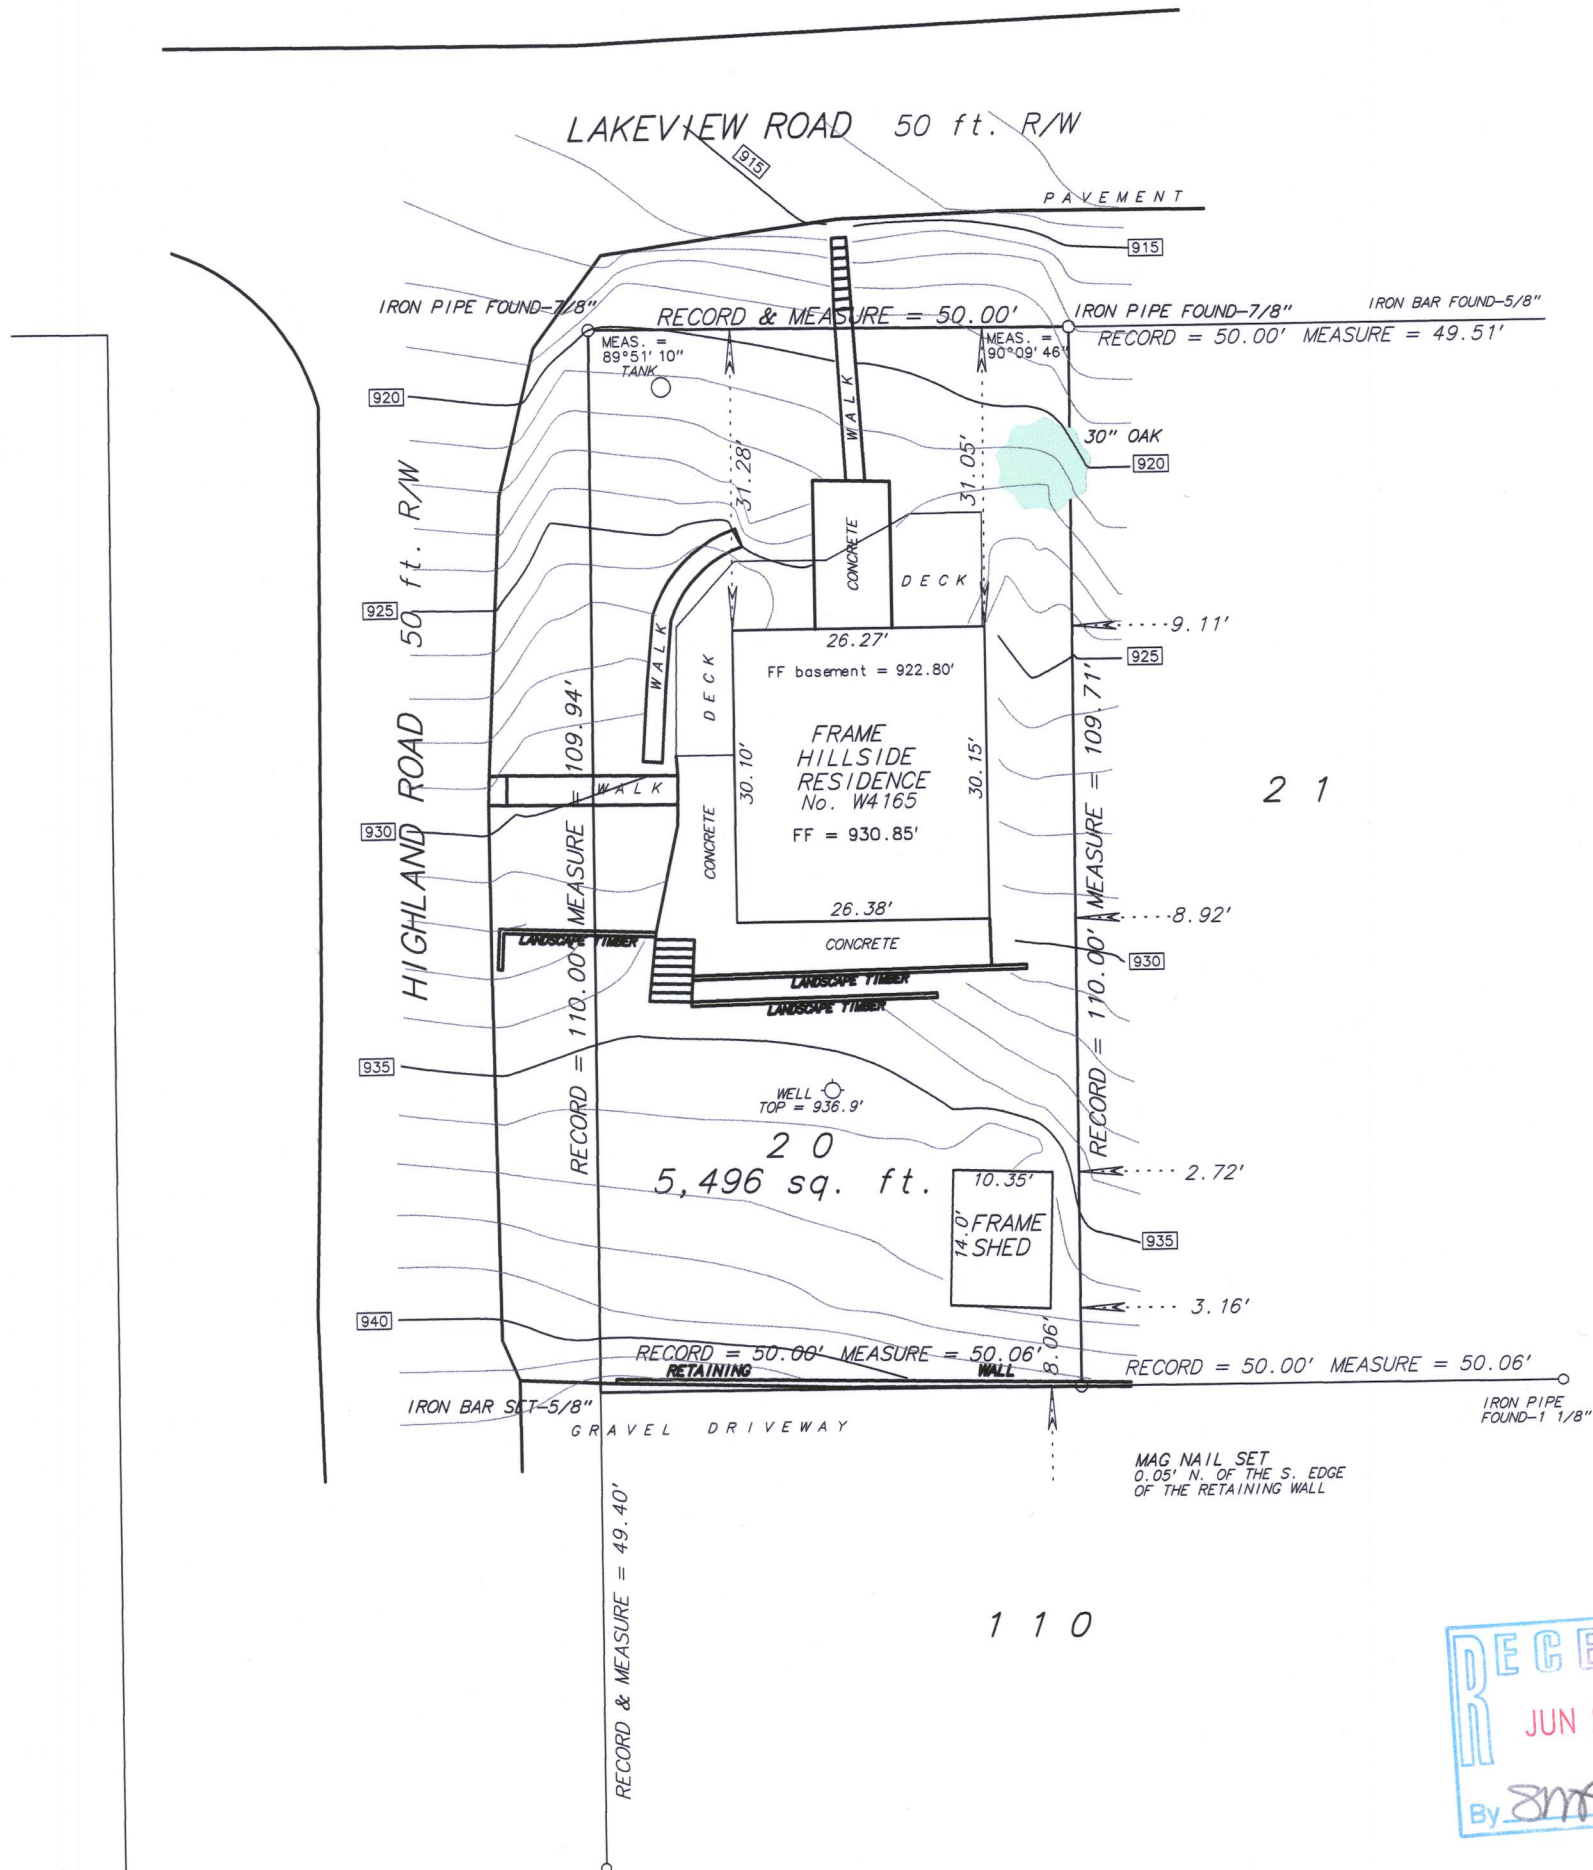


SCALE: 1 inch = 20 feet

ORDERED BY: J. Kopecky / Kopecky Architect Associates

JOB NO.: 17076

ILGH19

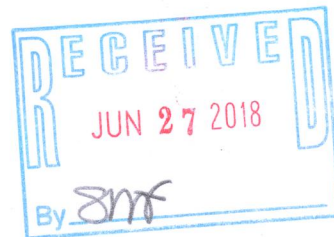

Fieldwork completed on and date of certification: February 22, 2017

I hereby certify that I have surveyed the above described property and the above plat is a true representation thereof and shows the size and location of the property, its exterior boundaries, the location and dimensions of all visible structures thereon, boundary lines, apparent easements and roadways and visible encroachments, if any.

This survey is made for the exclusive use of the present owners of the property, and also those who purchase, mortgage or guarantee the title thereto within ONE YEAR from the date hereof.

Dated at Bissett, Wisconsin this _____ day of _____ 2017.

Mark A. Bolender
Wisconsin Professional Land Surveyor - 1784

117-4142