AMBIT LAND SURVEYING

8120-312th Ave. Wheatland, WI. 53105-8934 Licensed Professionals in both Illinois & Wisconsin

PLAT OF SURVEY

PHONE:

262-537-4874

FAX:


262-537-4221

EMAIL:

ambit@tds.net

Lots 6,7,8,9 and 10, Block 7 of WOODDALE ADDITION, being part of the East Half of the Southwest Quarter of Section 9, and also part of the East Half of the Northwest Quarter of Section 16, Township 1 North, Range 17 East of the 4th Principal Meridian, Town of Linn, County of Walworth, State of Wisconsin.

Parcel Identification Number: IW 00056A

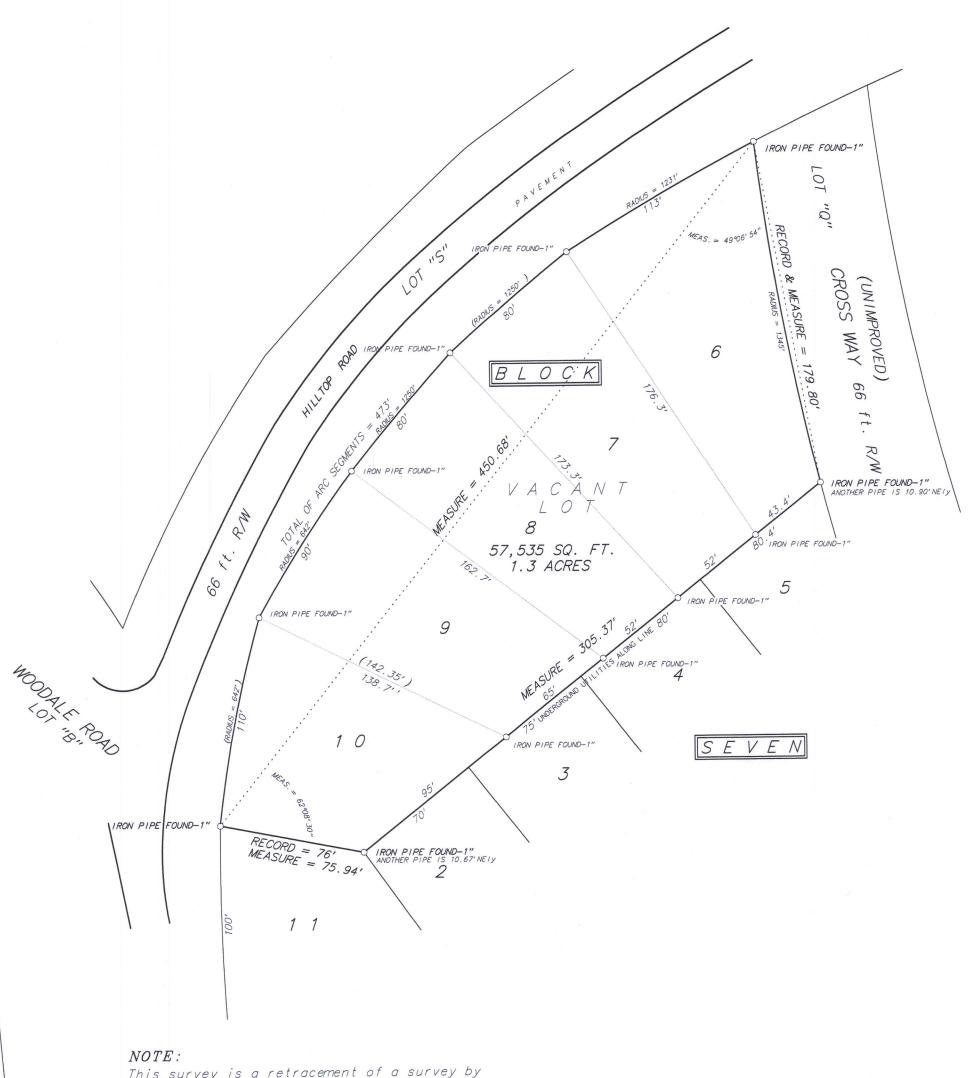

This survey is a retracement of a survey by Harold H. Kolb dated February 10, 1975.

(XXXXXXX) Denotes dimension per said survey



	-	4						
SC	AI	E:		1	inch	=	50	fee

ORDERED BY: C. Casper/ @Properties JOB NO.: _____17159

IW-56A

Mark A. Bolender Wisconsin Professional Land Surveyor - 1784

17-4143

July 25, 2017