LAND-MARK SURVEYING

Mark L. Miritz

Wisconsin Professional Land Surveyor S-2582

N9330 Knuteson Drive Whitewater, WI 53190 Phone: (262)495-3284 MARKMIRITZ@ LAND-MARKSURVEYING.COM


PLAT OF SURVEY


THE SOUTH 15 FEET OF LOT 36, LOT 37 AND THE NORTH 1/2 OF LOT 38 IN BLOCK "J", SAID LOTS BEING IN CISCO BEACH. A SUBDIVISION IN SECTION 5, TOWNSHIP 1 NORTH, RANGE 17 EAST OF THE FOURTH PRINCIPAL MERIDIAN, ACCORDING TO THE PLAT RECORDED ON OCTOBER 9, 1926 IN VOLUME 8 OF PLATS ON PAGES 103 AND 104 IN THE OFFICE OF THE REGISTER OF DEEDS FOR WALWORTH COUNTY, WISCONSIN. SAID LAND BEING IN THE TOWN OF LINN, COUNTY OF WALWORTH AND STATE OF WISCONSIN.

ORDERED BY: ERIC GOSTOMSKI PREMIER HOMES 1, INC. P.O. BOX 100 **WILLIAMS BAY, WI 53191**

SITE ADDRESS: **N2473 CISCO ROAD LAKE GENEVA, WI 53147**

WALWORTH COUNTY LAND US RESOURCE MANAGEMENT DEP

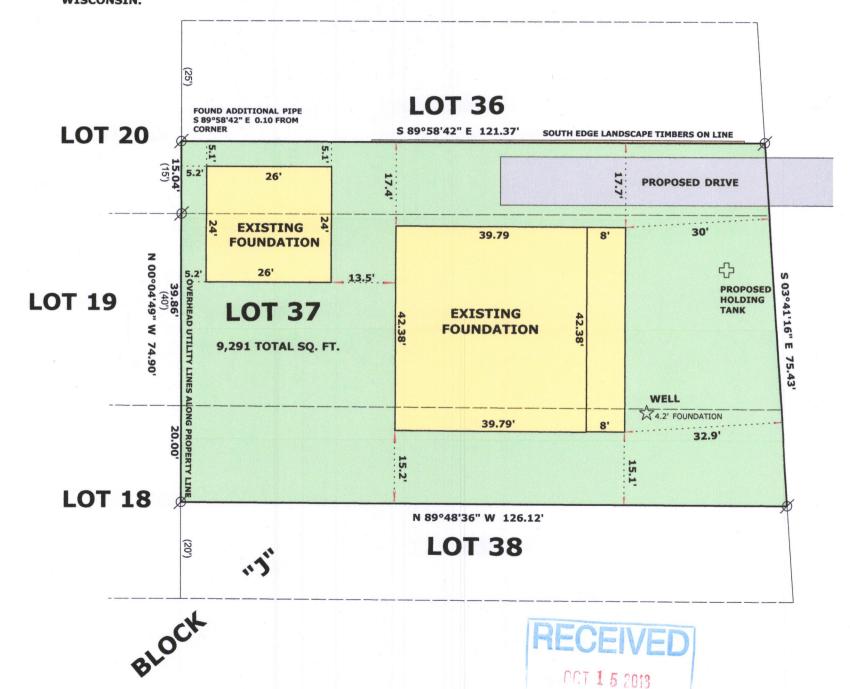

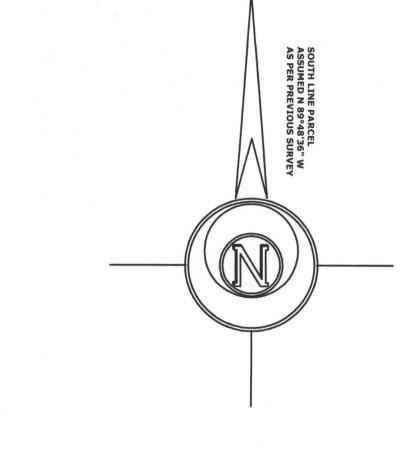





FOUND IRON PIPE

LEGEND

RECORDED AS DIMENSION

SCALE: 1 INCH = 20 FEET

"I hereby certify that the above described property has been surveyed by me or under my direction and that the above map is a true representation thereof and shows the size and location of the property, its exterior boundaries, the location of all visible structures and dimensions of all principal buildings thereon, boundary fences, apparent easements, roadways and visible encroachments, if any."

"This survey is made for the use of the present owners of the property, and also those who purchase, mortgage, or guarantee the title thereto within one year from date

> MARK L. MIRITZ WISCONSIN PROFESSIONAL **LAND SURVEYOR S-2582**

FOUNDATIONS "AS BUILT"

REVISESD SEPT. 3, 2018

FOR NEW LOCATION SHED

REVISED OCT. 11, 2018 TO

DATE: JUNE 19, 2018

ICI-240B

CISCO

ROAD

117-4173

JOB NO. 18.504