
PLAT OF SURVEY - OF -

LOT 18 OAK SHORES SUBDIVISION, LOCATED IN SECTION 8, TOWN 1 NORTH, RANGE 17 EAST, TOWN OF LINN, WALWORTH COUNTY, WISCONSIN.

SURVEY FOR: JIM SYKORA SURVEY ADDRESS: N 1530 OAK SHORE LANE

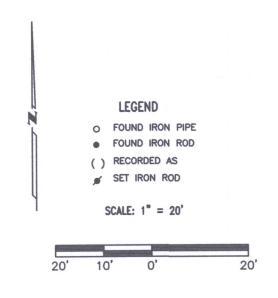


I hereby certify that I have surveyed the above described property and that the above map is a correct representation thereof and shows the size and location of the property, its exterior boundaries, the location of all visible structures and dimensions of all principal buildings thereon, boundary fences, apparent easements, roadways and encroachments, if any.

This survey is made for the use of the present owners of the property, and those who purchase mortgage or guarantee the title thereto within one year from date hereof.

LIBERTY LAND SURVEYING

N6795 County Road "A" Lot 12 LAKE MILLS, WISCONSIN 53551 (262)901-5116 (262)767-8786

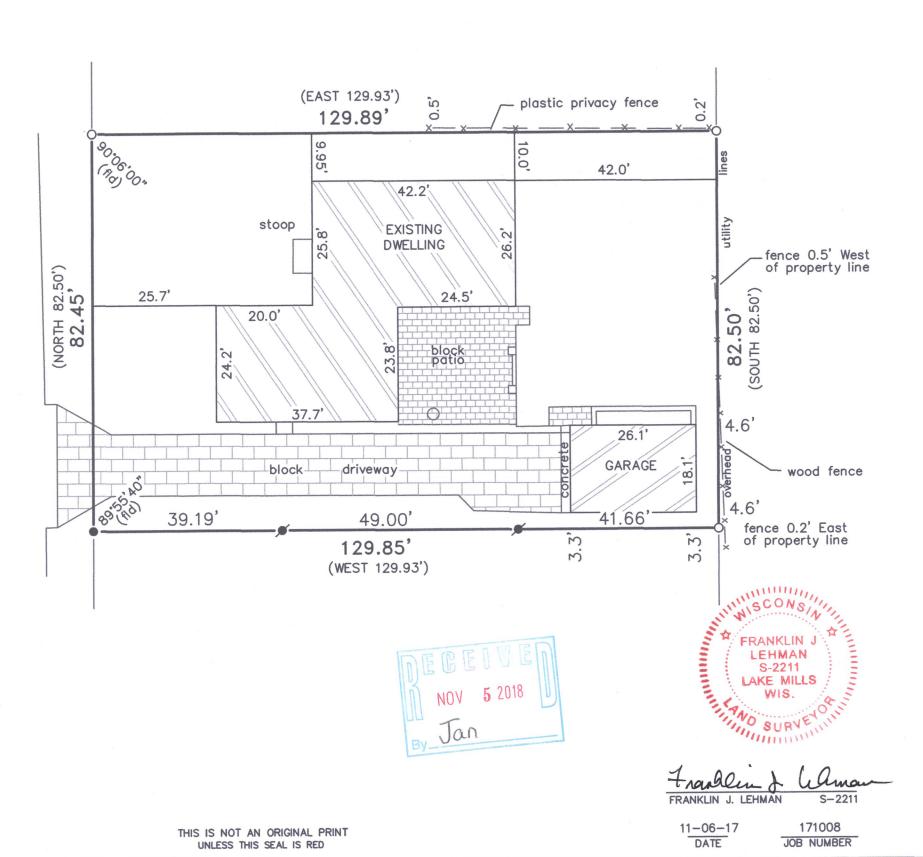

IO-18

117-4178